




Lease Name: Avex 10C

Legals: NENE – Sec. 10, T4N, R68W

County: Weld County, Colorado

API#: 05-123-35009

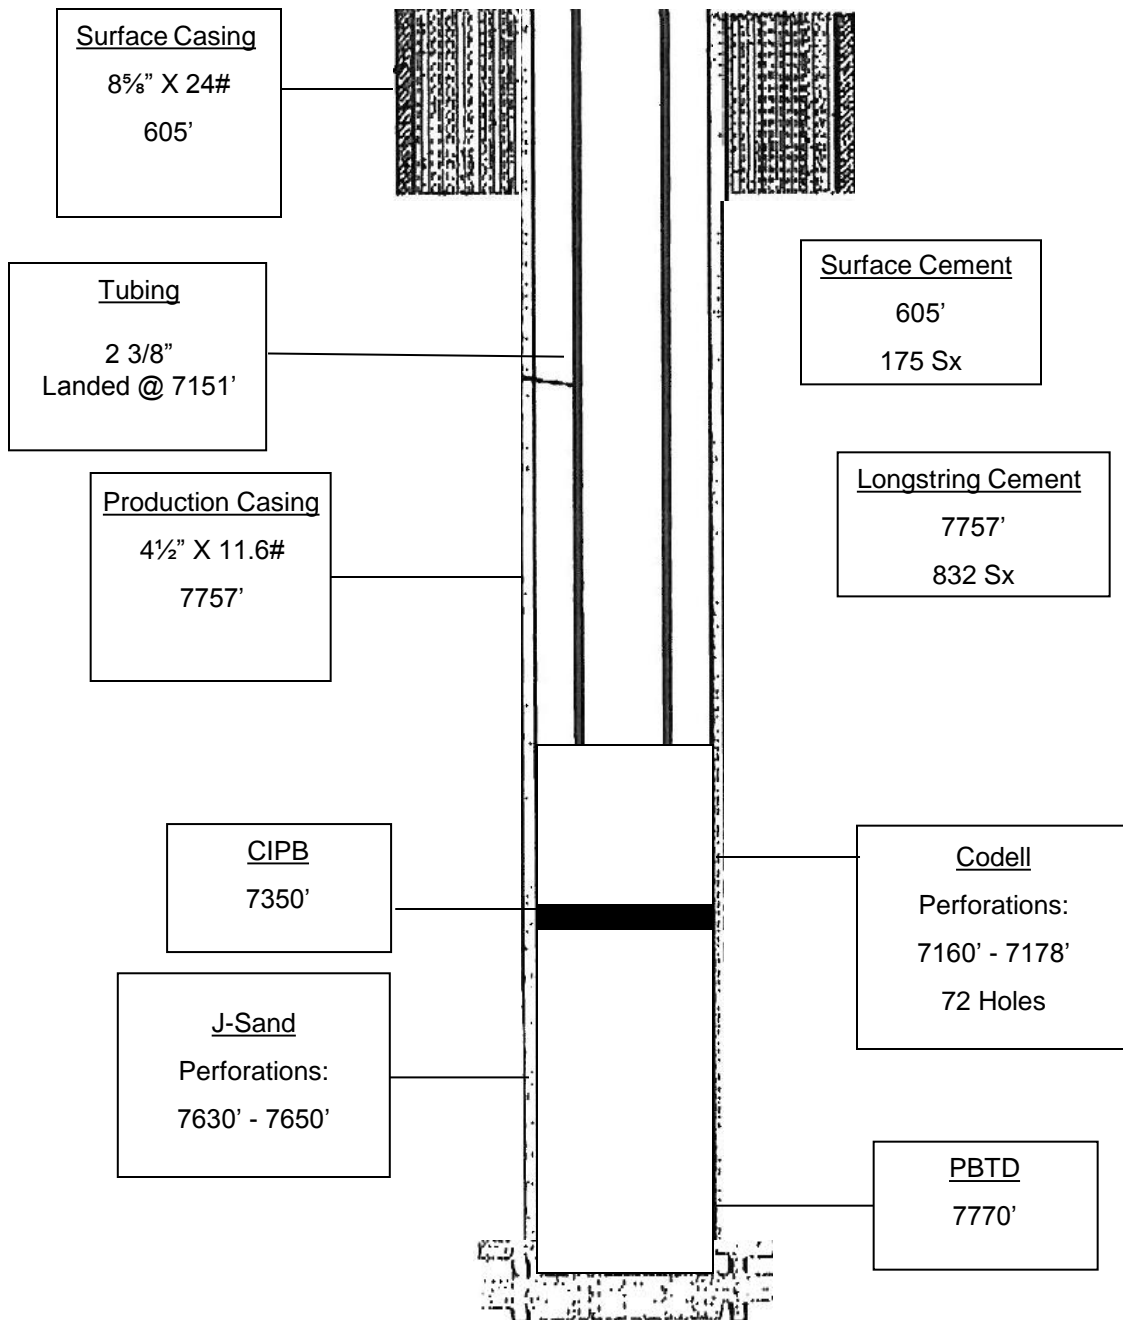

Wellbore Diagram