


STATE 36-3-9

WBD AFTER ABANDONING LOWER SECTION

CUT + PULL CSG + PUMP BALANCED PLUG TO KICK OFF OF
WBD READY TO COMMENCE DRILLING OPERATIONS

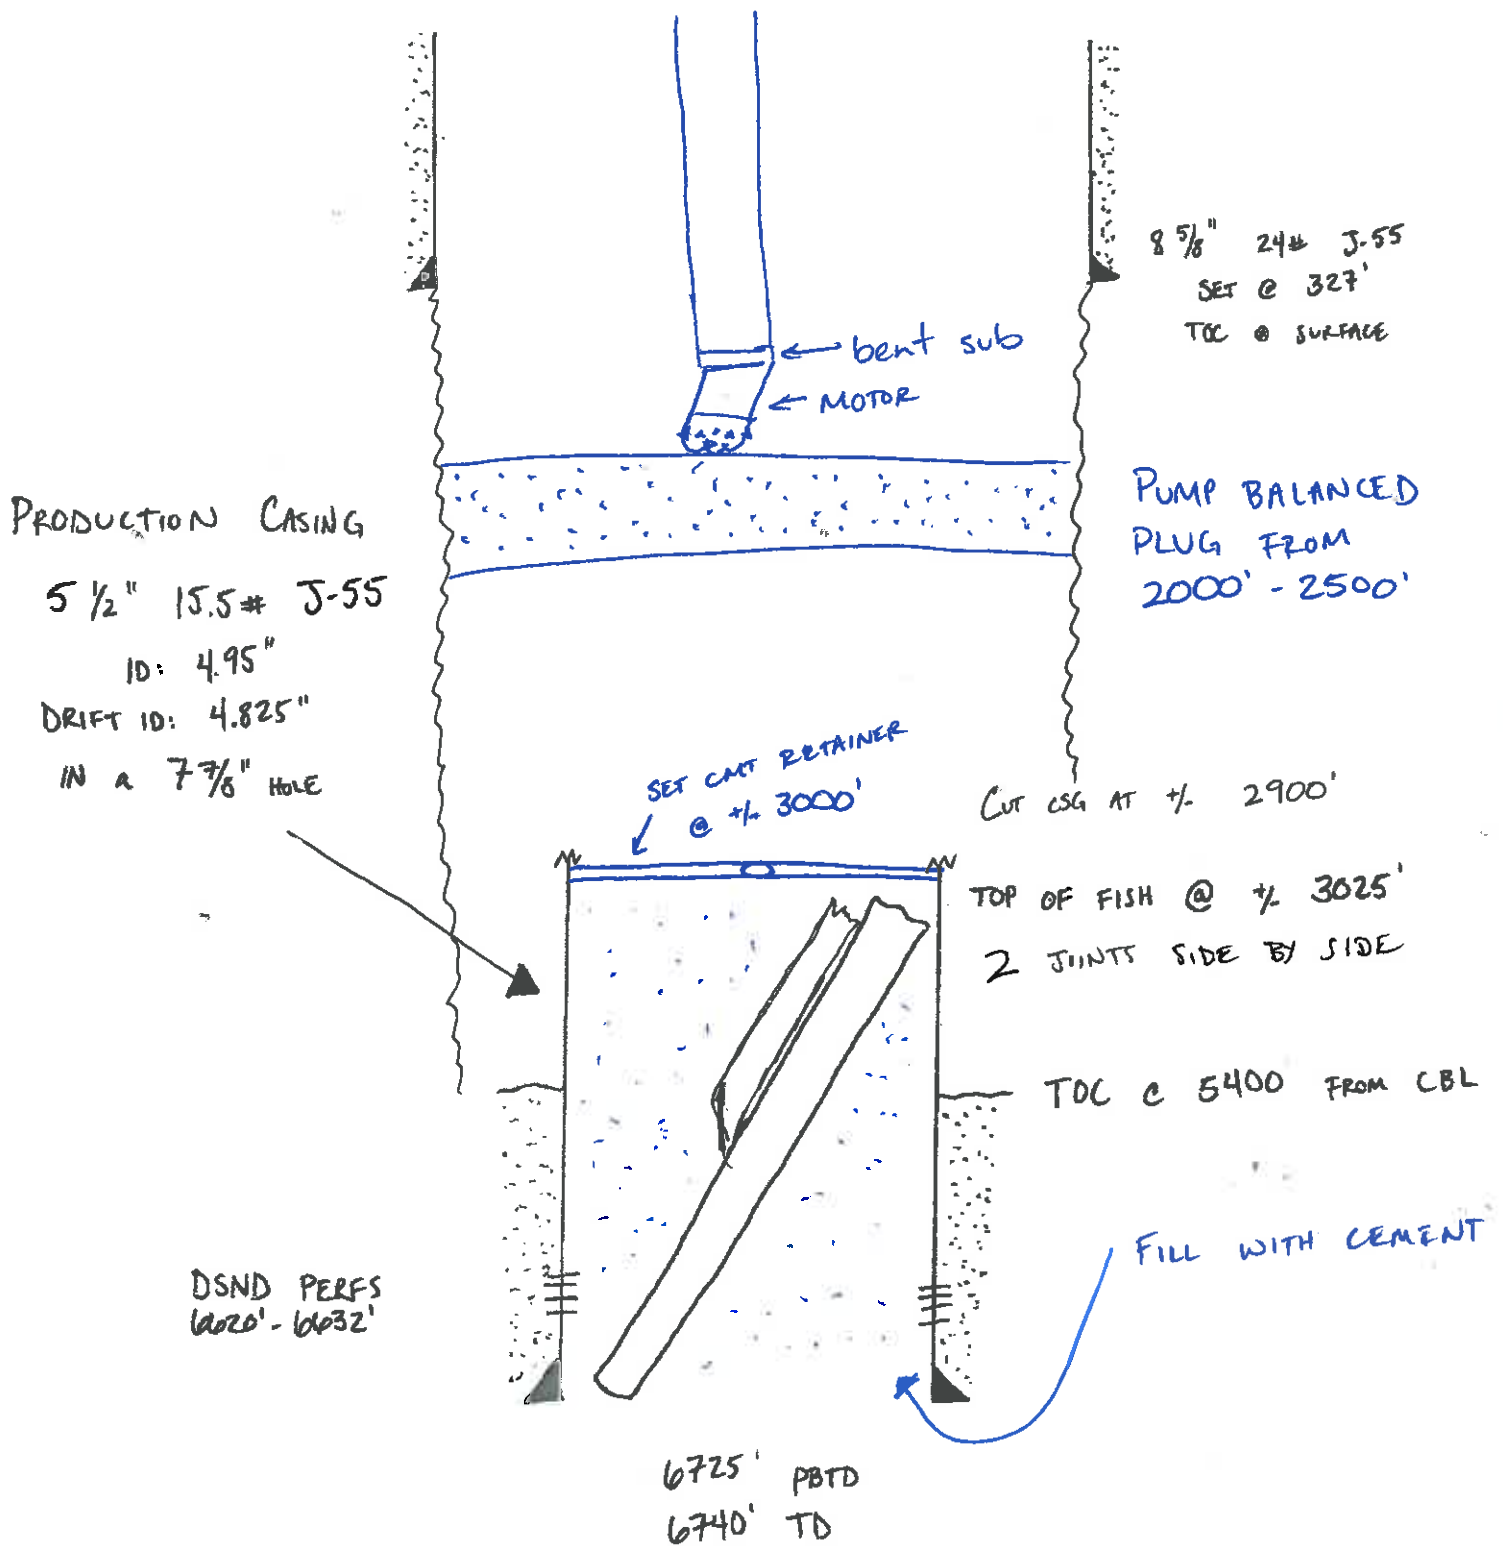

PREPARED BY: MATT STARK

4/3/2013