


**KERR-MCGEE OIL AND GAS ONSHORE LP**  
**EICHTHALER MARG 1**  
**SW SW 26 2N 65W 990' FSL 990' FWL**  
**WELD,COLORADO**  
**04/05/2013**

AREA: S5      ROUTE: S51    Spud: 08/10/1973    WINS No.: 75342    AFE/WO#: 88331981    API#: 0512307752

GL: 4918    KB: 4928    MTD: 7940    TVD: 7940    LOG MD:    PBMD: 7940    PBTVD: 7940

Directions: WCR 47 & WCR 16, W 7/10, N INTO

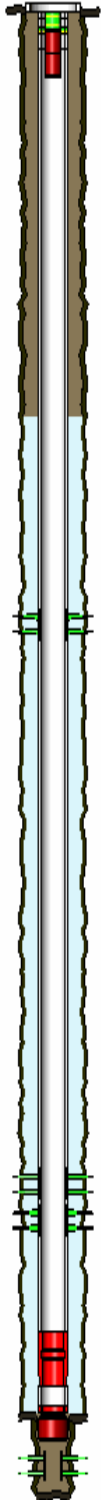

<u>HOLE SECTIONS</u>		<u>Size</u>	<u>Top</u>	<u>Btm</u>	<u>TD Date</u>			
SURFACE		12.25	10	235	08/11/1973			
PRODUCTION		7.88	235	7800	08/22/1973			
DEEPEMED		3.88	7800	7940	12/13/1996			
<u>TUBULARS</u>	<u>Tool Type</u>	<u>Joints</u>	<u>Size</u>	<u>Weight</u>	<u>Grade</u>	<u>Thread</u>	<u>Top D</u>	<u>Bottom D</u>
<b>SURFACE CASING</b>								
	Casing	5	8.63	23		STC	10	233
<b>PRODUCTION CASING</b>								
	Casing	2	4.50	11.6	K-55	STC	10	74
	Casing	28	4.50	10.5	K-55	STC	74	932
	Cement Stage Too	1	4.50				932	933
	Casing	184	4.50	10.5	K-55	STC	933	6618
	Casing	37	4.50	11.6	K-55	STC	6618	7761
	Casing Float Collar	1	4.50				7761	7762
	Casing	1	4.50	11.6	K-55	STC	7762	7796
	Casing Guide Shoe	1	4.50				7796	7797
<b>CICR</b>								
	Wellbore Equipment	1	4.50				7800	7801
<b>PRODUCTION TUBING</b>								
		214	2.38	4.70	j-55	8RD EUE	10	6755
	Wellbore Equipment	1	2.38				6755	6756
	Wellbore Equipment	1					6756	6757
<u>CEMENT JOBS</u>	<u>Stage</u>	<u>Sacks</u>	<u>Cement Jobs</u>			<u>Top D</u>	<u>Btm D</u>	<u>cbl</u>
<b>SURFACE CASING</b>								
	STAGE 1	200		G		10	233	No
<b>PRODUCTION CASING</b>								
	PRIM CMT 2ND STAGI	200		FRESH WATER		550	932	No
<b>PRODUCTION CASING</b>								
	PRIM CMT 1ST STAGE	200		50/50 POZ-MIX		7044	7797	Yes
<u>PERFORATIONS</u>								
<u>Formation</u>	<u>Zone</u>	<u>Top</u>	<u>Btm</u>	<u>Date</u>	<u>Reason</u>	<u>Comments</u>		
CODELL		7208	7220	05/20/1995	PRODUCTION			
J SAND		7669	7677	10/14/1973	PRODUCTION			
J SAND		7682	7691	10/14/1973	PRODUCTION			
DAKOTA		7854	7900	12/15/1996	PRODUCTION			

Comments: