


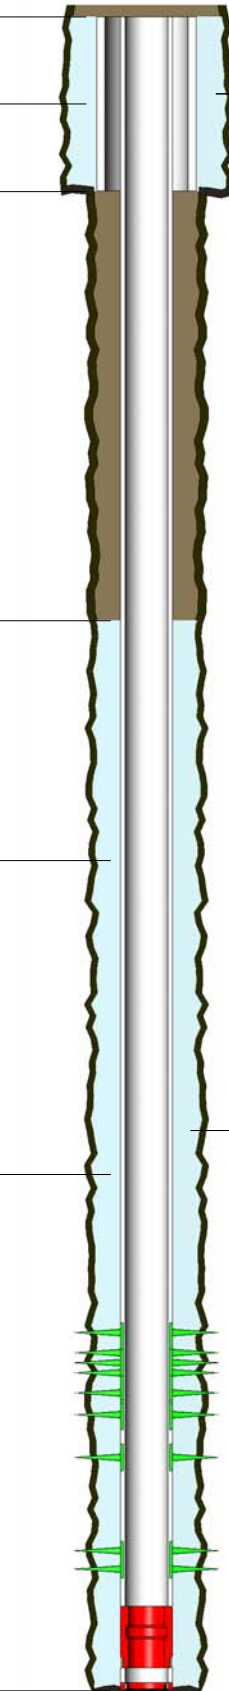

Company: US ROCKIES REGION Site: WARNER 5-14
Project: COLORADO-WELD-NAD83-UTM13 Common Well Name: WARNER 5-14

API No: 0512321998 Datum: RKB Section: 14 Div of Quarter Section: SW
Latitude: 40.139682° Elevation: 5,075.0usft Township: 2 N Div of Section: NW
Longitude: -104.751463° Water Depth: 5,059.0usft Range: 66 W

Casing Information	Casing Size & Weight	Cement Fluid (sacks)	Cement Depths (ft)	Schematic (11/3/2013)	Hole Size (in)	MD / PBMD (usft)	Perforation Intervals (usft)
SURFACE CASING - Set @ 987.0usft	8.625in, 24.00ppf	LEAD, LITE, 267 TAIL, NEAT, 100	16 (TOC) 500 987		12.250		
PRODUCTION CASING - Set @ 7,655.0usft	4.500in,		3376 (TOC) 4710				
	4.500in,	MIDDLE, LIQUID LEAD, LIQUID STONE, 102 TAIL, LIQUID STONE, 140	6458 7655		7.875	MD: 7,640 PBMD: 7,629	7,280 - 7,292 - NIOBRARA 7,282 - 7,284 - NIOBRARA 7,291 - 7,293 - NIOBRARA 7,372 - 7,384 - NIOBRARA 7,505 - 7,522 - CODELL