


Final Well Report Detailed (graphic)

Well Name: DW 8608C-28 P28 496

API # 05045207970000	Well Type Gas	Business Unit Southern Rockies	SBU North Piceance	Area Double Willow	Pad P28 496	State CO	County/Parish GARFIELD
-------------------------	------------------	-----------------------------------	-----------------------	-----------------------	----------------	-------------	---------------------------

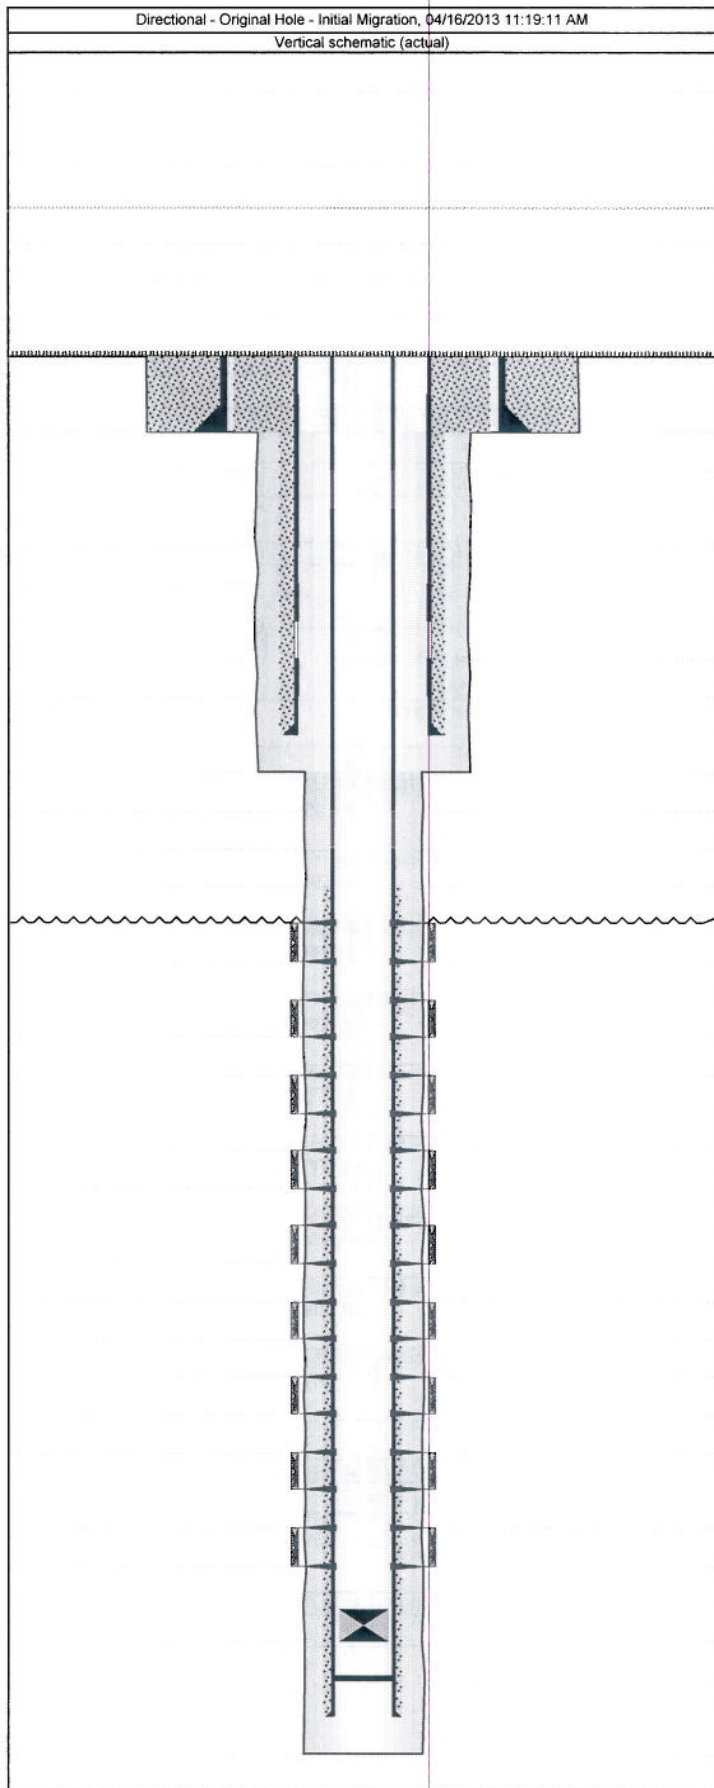


Well Header Setup					
Well Name DW 8608C-28 P28 496			API # 05045207970000		
Original KB Elevation (ft) 7,813.00		Ground Elevation (ft) 7,791.00		Spud Date 01/25/2012	Final Rig Release Date 06/14/2012
Surface Legal Location			Latitude (decimal) (°) 39.66809500		Longitude (decimal) (°) -108.16571600
Wellbore Sections Setup					
Wellbore Type Original Hole - Initial Migration			Kick Off Depth (ftKB) 342.12		VS Dir (°) 342.12
Section Des		Hole Size (in)		Act Top (ftKB)	Act Btm (ftKB)
Conductor		30		22.0	118.0
Surface		14 3/4		118.0	2,155.0
Production		7 7/8		2,155.0	11,654.0
Plug Back Total Depths					
Date	Depth (ftKB)	Method		Com	
09/26/2012	11,566.0			Wellcore PBTD (TVD): 10957.0000166546	
Casing Data					
Conductor					
Casing Description Conductor			Run Date 12/03/2011		Set Depth (ftKB) 118.0
Item Des	OD (in)	ID (in)	Wt (lb/ft)	Grade	Len (ft)
Casing Joints	20				120.00
Surface					
Casing Description Surface			Run Date 01/27/2012		Set Depth (ftKB) 2,132.0
Item Des	OD (in)	ID (in)	Wt (lb/ft)	Grade	Len (ft)
Casing Joints	9 5/8	8.921	36.00	J-55	27.00
Casing Joints	9 5/8				5.00
Casing Joints	9 5/8	8.921	36.00	J-55	1,922.19
Casing Joints	9 5/8				1.60
Casing Joints	9 5/8	8.921	36.00	J-55	134.09
Float Collar	9 5/8				1.50
Casing Joints	9 5/8	8.921	36.00	J-55	44.72
Float Shoe	9 5/8				1.50
Production					
Casing Description Production			Run Date 06/14/2012		Set Depth (ftKB) 11,589.0
Item Des	OD (in)	ID (in)	Wt (lb/ft)	Grade	Len (ft)
Guide Shoe	5 1/2		11.60	P-110	1.50
Casing Joints	4 1/2	4.000	11.60	P-110	20.22
Float Collar	5 1/2		11.60	P-110	1.50
Casing Joints	4 1/2	4.000	11.60	P-110	1,469.41
Marker Joint	4 1/2	4.000	11.60	P-110	20.62
Casing Joints	4 1/2	4.000	11.60	P-110	2,665.64
Marker Joint	4 1/2	4.000	11.60	P-110	20.98
Casing Joints	4 1/2	4.000	11.60	P-110	7,392.30
Cement Data					
Conductor, 118.0ftKB Proposed? No					
Description Conductor Cement		String Conductor, 118.0ftKB Proposed? No		Wellbore Original Hole - Initial Migration	
Type Casing					
Stg # 1	Description Conductor			Top (ftKB) 22.0	Full Return?
Btm (ftKB) 118.0					
Sequence		Fluid Des		Amount (sacks)	Class
Tail		Control Set C		239	
Surface, 2,132.0ftKB Proposed? No					
Description Surface Casing Cement		String Surface, 2,132.0ftKB Proposed? No		Wellbore Original Hole - Initial Migration	
Type Casing					
Stg # 1	Description Surface			Top (ftKB) 22.0	Full Return?
Btm (ftKB) 2,132.0					

Final Well Report Detailed (graphic)

Well Name: DW 8608C-28 P28 496

API # 05045207970000	Well Type Gas	Business Unit Southern Rockies	SBU North Piceance	Area Double Willow	Pad P28 496	State CO	County/Parish GARFIELD
-------------------------	------------------	-----------------------------------	-----------------------	-----------------------	----------------	-------------	---------------------------

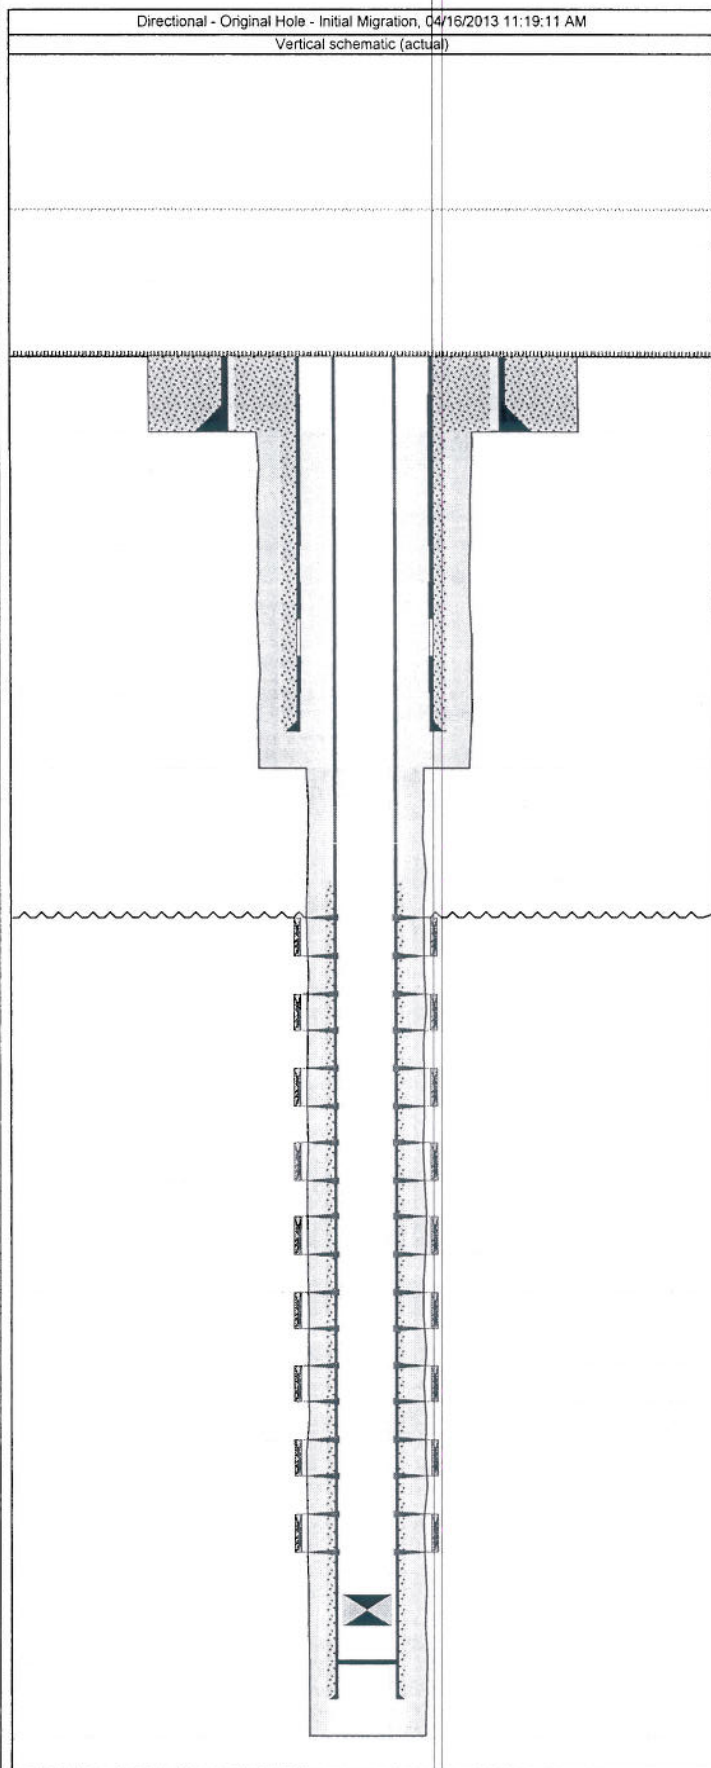

Sequence	Fluid Des	Amount (sacks)	Class
Tail	12.5# LiteFILL	245	
Lead	11# LiteFILL	471	

Production, 11,589.0ftKB Proposed? No

Description	String	Wellbore	Type
Production Casing Cement	Production, 11,589.0ftKB Proposed? No	Original Hole - Initial Migration	Casing

Stg #	Description	Top (ftKB)	Btm (ftKB)	Full Return?
1	Production	4,958.0	11,589.0	

Sequence	Fluid Des	Amount (sacks)	Class
Tail	13# Rockies Correct Tail	630	
Lead	12.0 POZ/G lead	1,602	

Tubing Data

Tubing Description	Tubing Set Date	Set Depth (ftKB)

Item Des	OD (in)	ID (in)	Len (ft)

Rod Data

Rod Description	Run Date	Set Depth (ftKB)

Item Des	OD (in)	Len (ft)

Zones

Zone Name	Wellbore	Top Depth (ftKB)	Btm (ftKB)
Original Migration	Original Hole - Initial Migration		

Cur Stat Date	Current Status	Formation(s)

Perforation Data

Stage #	Type	Top Depth (ftKB)	Bottom Depth (ftKB)	Zone
9	Perforated	7,838.0	8,195.0	Original Migration, Original Hole - Initial Migration
8	Perforated	8,278.0	8,584.0	Original Migration, Original Hole - Initial Migration
7	Perforated	8,619.0	8,995.0	Original Migration, Original Hole - Initial Migration
6	Perforated	9,060.0	9,382.0	Original Migration, Original Hole - Initial Migration
5	Perforated	9,423.0	9,770.0	Original Migration, Original Hole - Initial Migration
4	Perforated	9,806.0	10,186.0	Original Migration, Original Hole - Initial Migration
3	Perforated	10,234.0	10,593.0	Original Migration, Original Hole - Initial Migration
2	Perforated	10,679.0	10,989.0	Original Migration, Original Hole - Initial Migration
1	Perforated	11,041.0	11,391.0	Original Migration, Original Hole - Initial Migration

Other In Hole

OD (in)	Des	Top (ftKB)	Btm (ftKB)	ID (in)	Make	Model
3 1/2	Bridge Plug - Permanent	11,530.0	11,531.0		Owen 10k	

Wellhead Description

Install Date	Type	Make	Size (in)	WP (psi)

Make	Model	Section	Top Sz (in)	Btm Sz (in)	WP (psi)