




Lease Name: Pratt 2KD

Legals: NESW – Sec. 2, T4N, R68W

County: Weld County, Colorado

API#: 05-123-36387

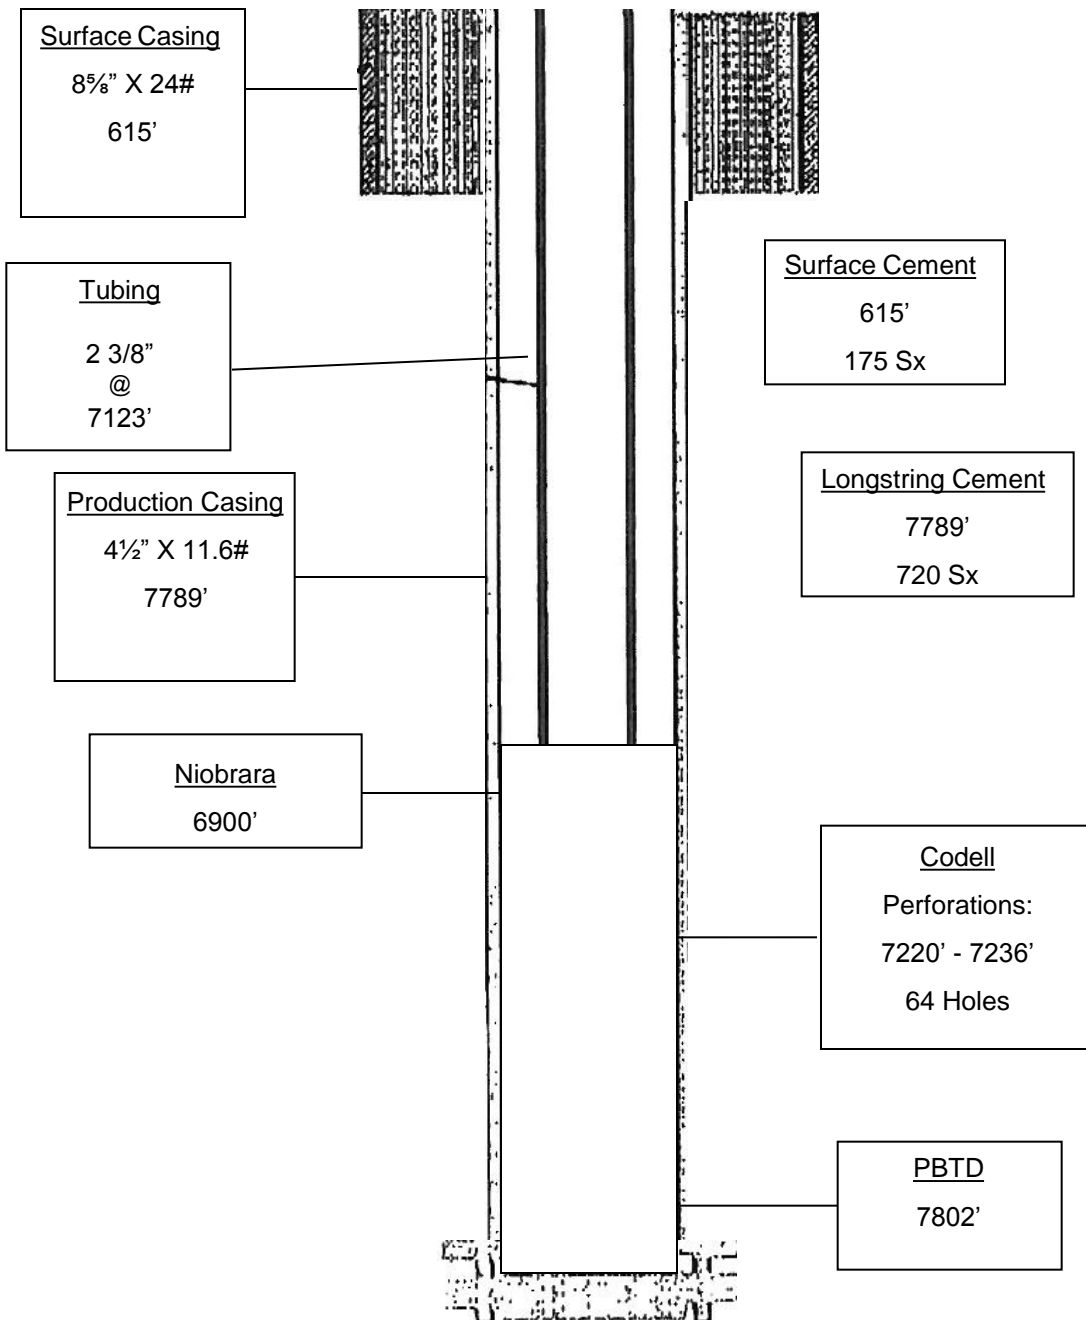

Wellbore Diagram