




Lease Name: Avex 21-2D

Legals: NENW – Sec. 2, T4N, R68W

County: Weld County, Colorado

API#: 05-123-35224

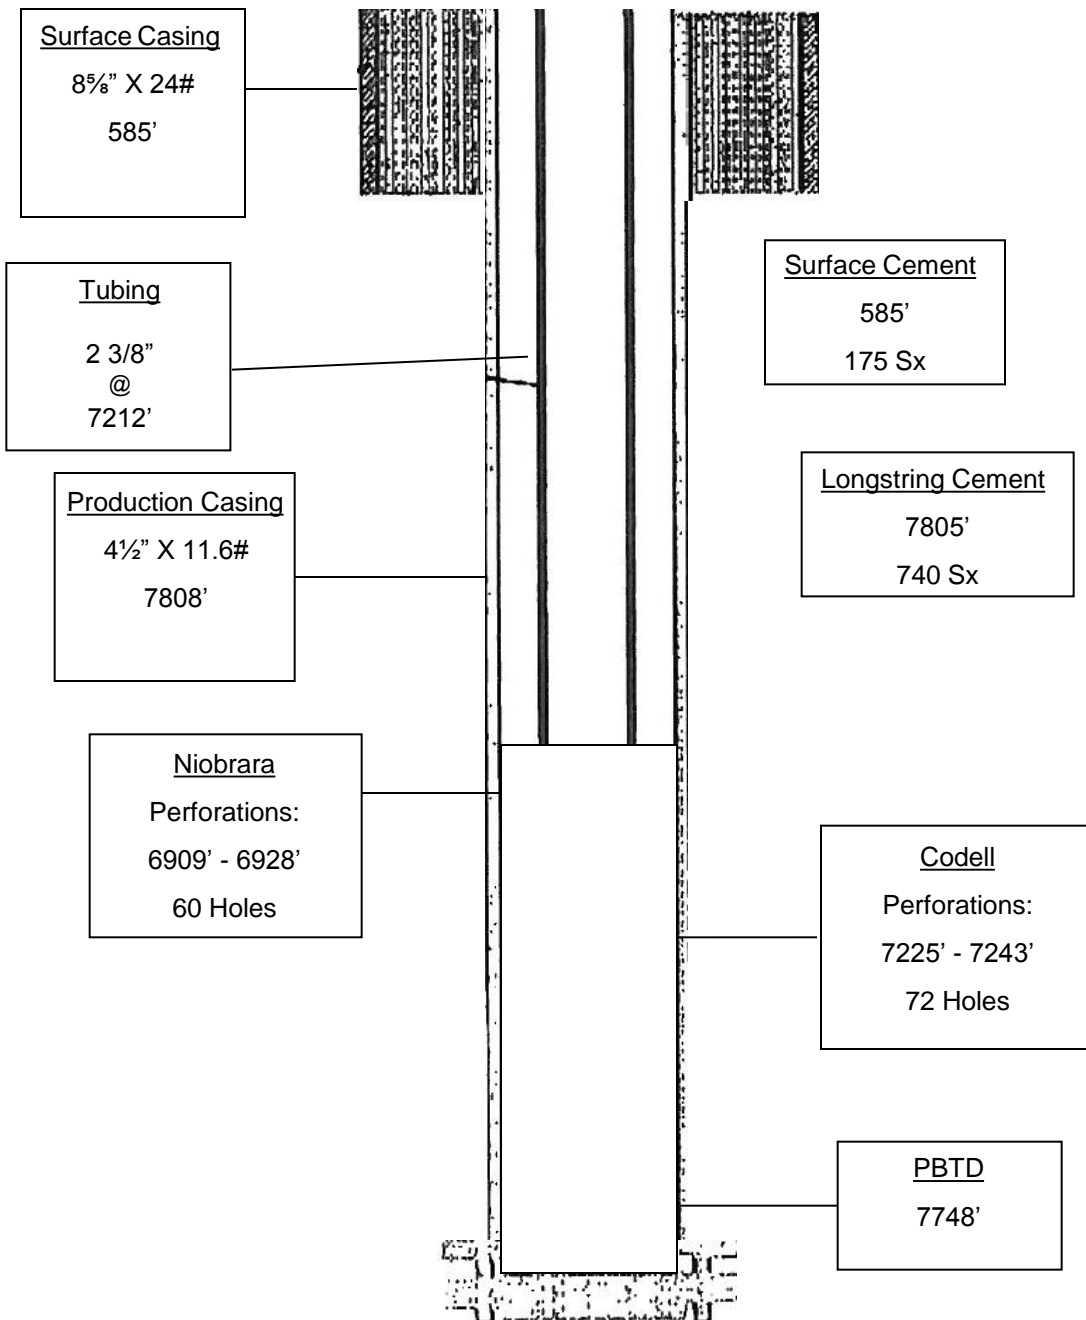

Wellbore Diagram