


DALEY LAND SURVEYING, INC.

PARKER, CO. 80134

303 953 9841

PRODUCTION FACILITY LOCATION DRAWING VIGILANT STATE AC16-06 PRODUCTION FACILITY

SECTION 16, TOWNSHIP 7 NORTH, RANGE 63 WEST OF THE 6TH PRINCIPAL MERIDIAN

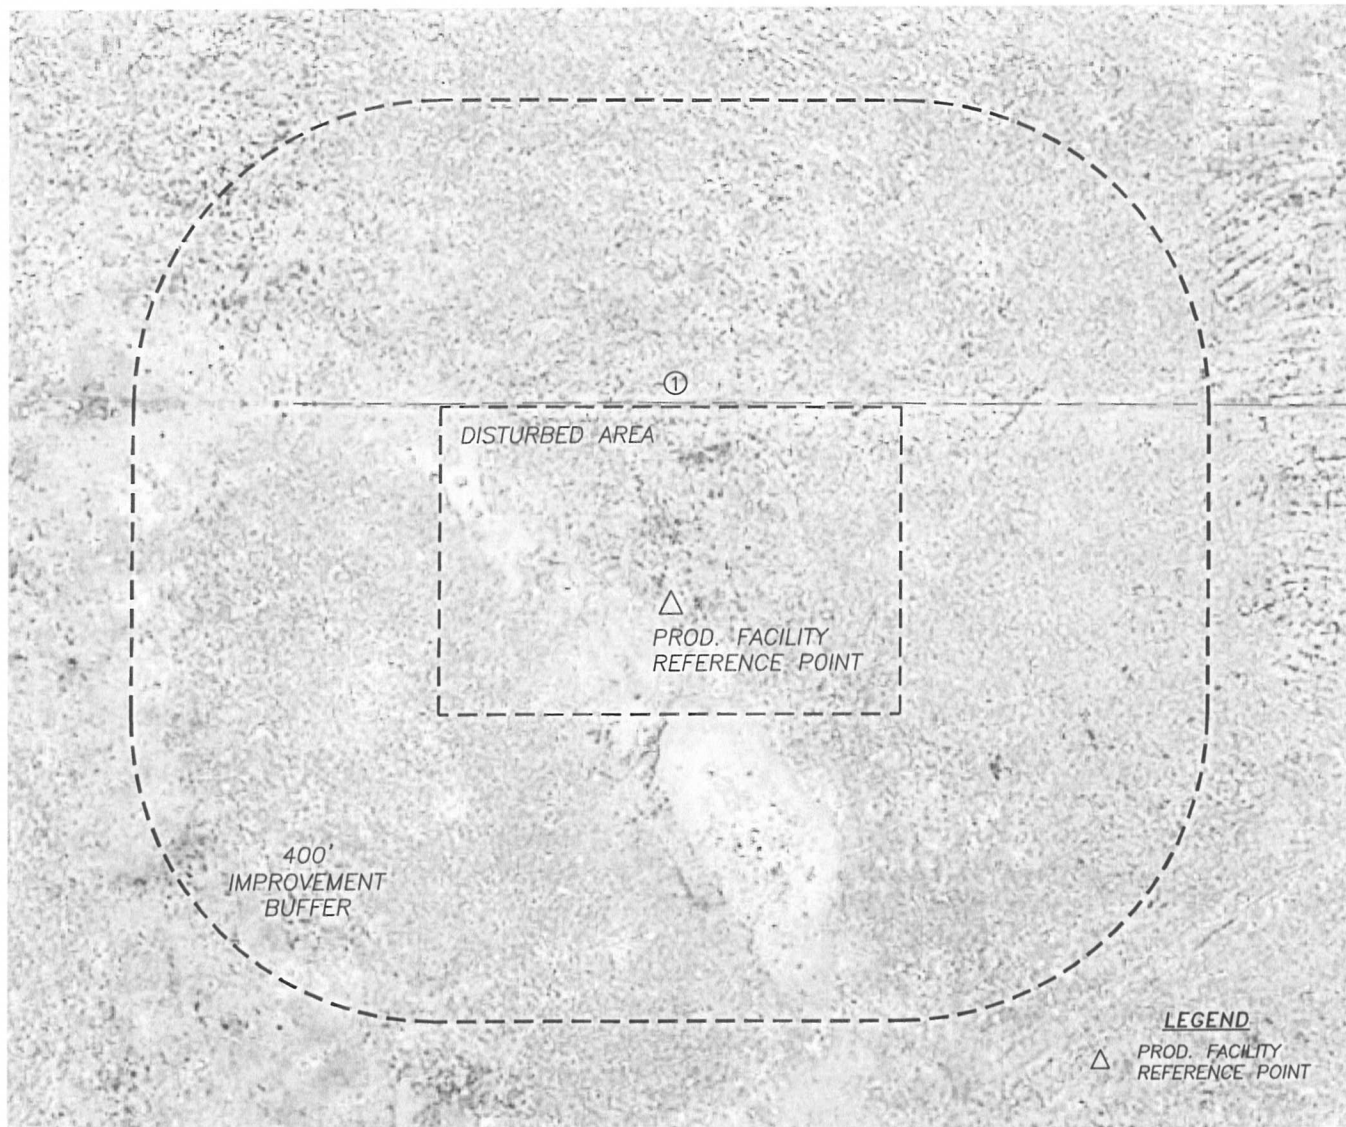

REFERENCE POINT LOCATION:

LATITUDE: N40.57763°
LONGITUDE: W104.44679°
ELEV.: 4822'
PDOP.: 1.4
FOOTAGE: 1398' FNL, 1269' FWL
QTR/QTR: SW4/NW4
DATE: 2/14/2013

ASSOCIATED EXISTING WELLS
NONE

ASSOCIATED NEW WELLS:
VIGILANT STATE AC16-03
VIGILANT STATE AC16-05
VIGILANT STATE AC16-06

DISTANCE TO NEAREST:

BUILDING: 4486± SW
PUBLIC ROAD: 4130± SW
OVERHEAD UTILITY: 3985± S
RAILROAD: 5280'+
PROP. LINE: 1269± W

IMPROVEMENTS

1. OLD 2 TRACK: 263± N



0 250
SCALE: 1" = 250'