




Lease Name: Avex 35D

Legals: NWSE – Sec. 35, T5N, R68W

County: Larimer County, Colorado

API#: 05-069-06441

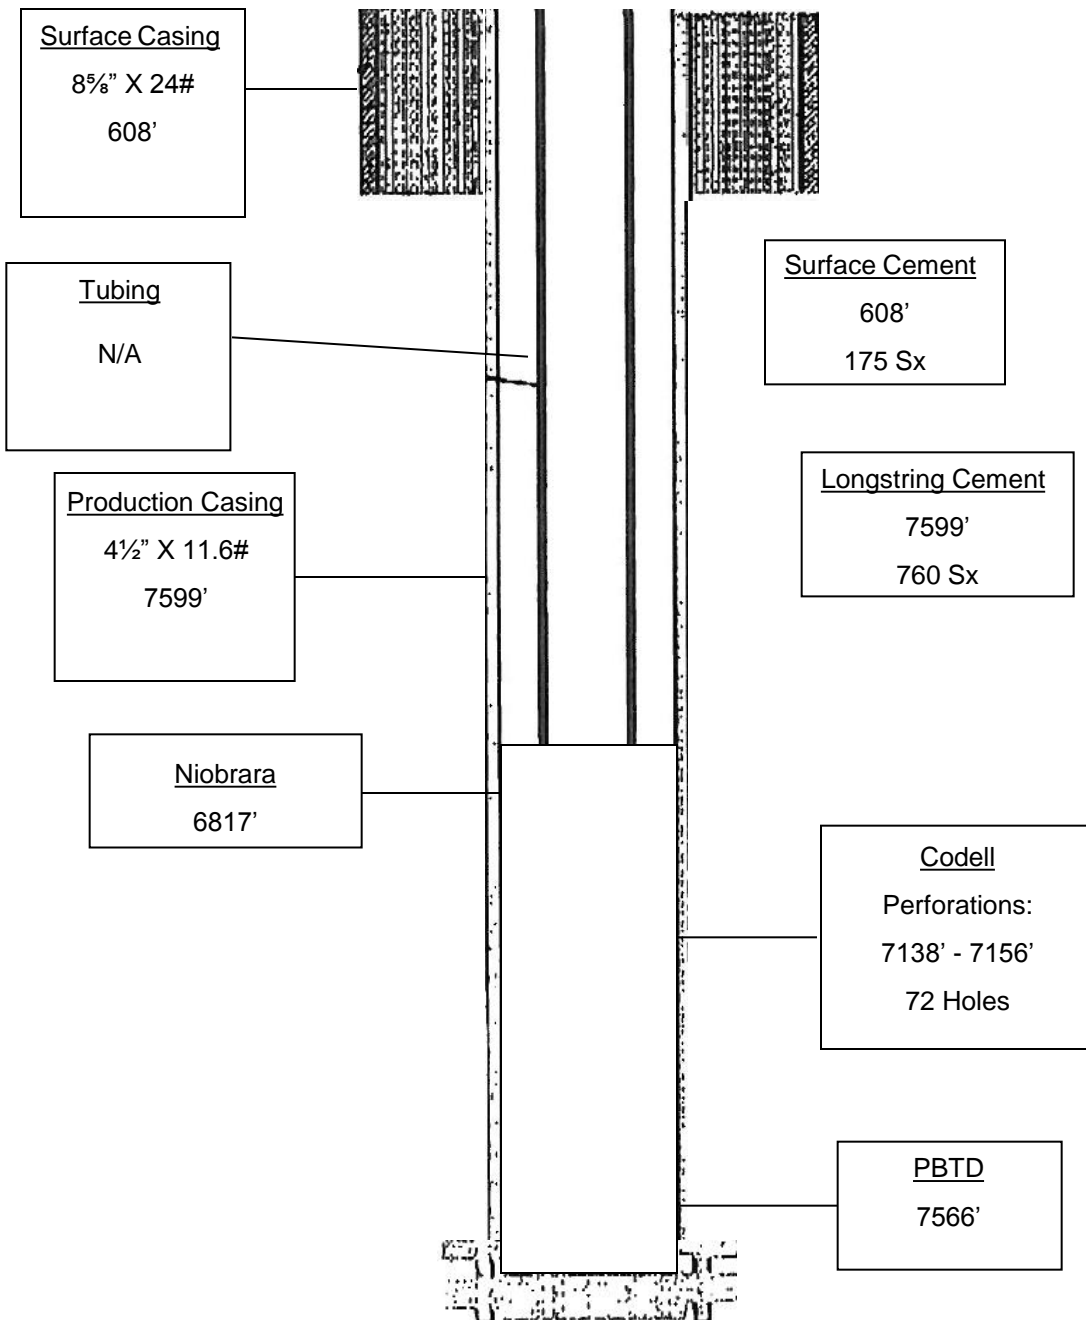

Wellbore Diagram