

KERR-MCGEE OIL AND GAS ONSHORE LP

CANNON LAND 9-15A

NE SE 15 2N 66W -- --

WELD,COLORADO

04/18/2013

AREA: S4

ROUTE: S42 Spud: 05/16/2003

WINS No.: 73693

AFE/WO#: 88336581

API#: 0512321429

GL: 5050

KB: 5062

MTD: 8110


TVD: 8110

LOG MD:

PBMD: 8067

PBTVD: 8067

Directions: CR 20 AND CR 31, E 7/10, N 3/10, E INTO.

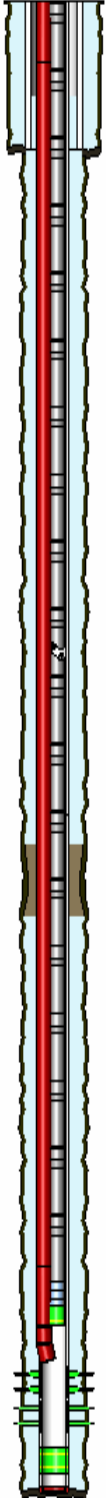

<u>HOLE SECTIONS</u>	<u>Size</u>	<u>Top</u>	<u>Btm</u>	<u>TD Date</u>				
SURFACE	12.25	12	934	05/17/2003				
PRODUCTION	7.88	934	8110	05/21/2003				
<u>TUBULARS</u>	<u>Tool Type</u>	<u>Joints</u>	<u>Size</u>	<u>Weight</u>	<u>Grade</u>	<u>Thread</u>	<u>Top D</u>	<u>Bottom D</u>
SURFACE CASING	Casing	21	8.63	24	J-55	STC	12	921
PRODUCTION CASING	Casing	121	4.50	11.6	I-80	LTC	12	5037
		1	4.50				5037	5040
	Casing	71	4.50	11.6	I-80	LTC	5040	8067
		1	4.50				8067	8068
	Casing	1	4.50	11.6	I-80	LTC	8068	8096
	Casing Guide Shoe	1	4.50				8096	8097
PRODUCTION TUBING	Tubing	251	2.38	4.7	J-55	8RD EUE	12	7923
	Seating Nipple	1	2.38				7923	7924
	Notched Collar	1	2.38				7924	7925
PRODUCTION TUBING	Wellbore Equipment	253	2.38		J-55		12	7928
	Wellbore Equipment	1	2.38				7928	7929
	Wellbore Equipment	1	2.38				7929	7930
<u>CEMENT JOBS</u>	<u>Stage</u>	<u>Sacks</u>	<u>Cement Jobs</u>	<u>Top D</u>	<u>Btm D</u>	<u>cbl</u>		
SURFACE CASING	STAGE 1	600	NEAT	12	921	No		
PRODUCTION CASING	STAGE 1	440	50/50 POZ-MIX	5658	8096	No		
	STAGE 2	150	LITE	3800	5214	No		
PRODUCTION CASING	SQUEEZE JOB			590	3800	No		
<u>PERFORATIONS</u>	<u>Formation</u>	<u>Zone</u>	<u>Top</u>	<u>Btm</u>	<u>Date</u>	<u>Reason</u>	<u>Comments</u>	
	J SAND		7957	7962	06/02/2003	PRODUCTION		
	J SAND		7980	7995	06/02/2003	PRODUCTION		

Comments: