




Plug and Abandon Wellbore Schematic

Well Name: DCU #36 (L23)

API #	Well Type	Business Unit	SBU	Area	Pad	State	County/Parish
05077088090000	Gas	Southern Rockies	South Piceance	Divide Creek	L23	CO	MESA

Directional - Original Hole - Initial Migration, 04/22/2013 1:56:38 PM

Vertical schematic (actual)

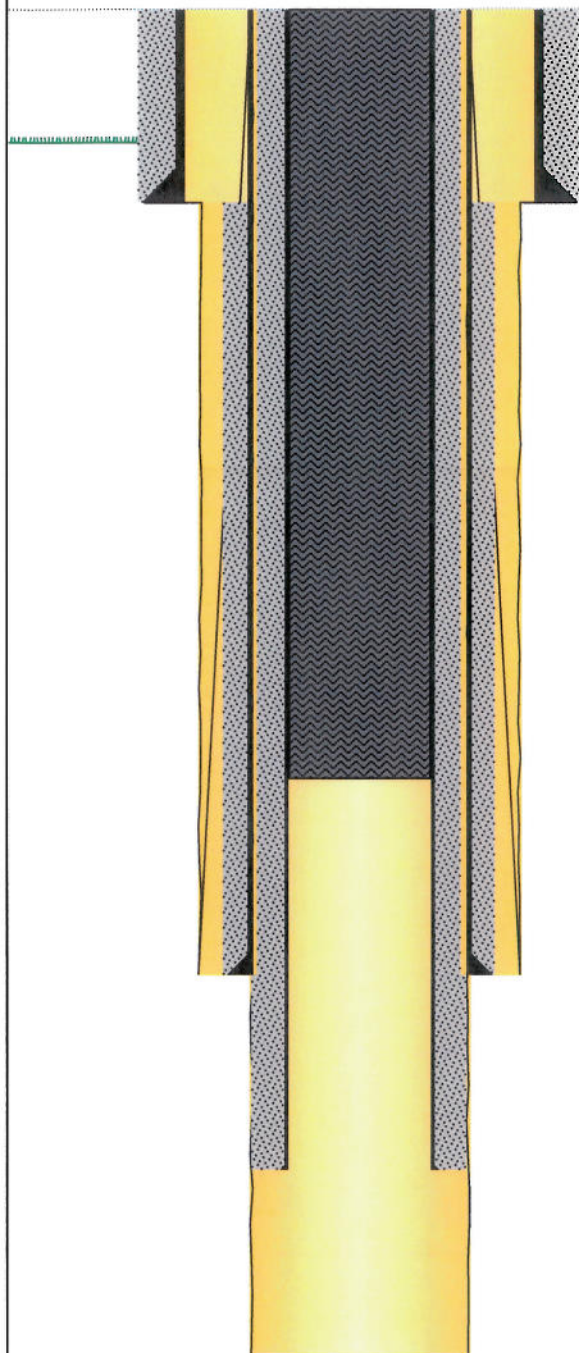

Well Header Setup

Well Name		API #	
DCU #36 (L23)		05077088090000	
Original KB Elevation (ft)	Ground Elevation (ft)	Spud Date	Final Rig Relea...
9,881.89	9,855.64	01/20/2007	
Surface Legal Location		Latitude (decimal) (°)	Longitude (decimal) (°)
		39.34329500	-107.52624500

Wellbore Sections Setup

Section Des	Hole Size (in)	Act Top (ftKB)	Act Btm (ftKB)
Conductor	38	0.0	38.0
Surface	19	0.0	2,503.5
Conductor	28	38.0	504.0

Plug Back Total Depths

Date	Depth (ftKB)	Method
08/20/2009		

Cement Data

Conductor, 38.0ftKB Proposed? <proposedrun>

Cementing Start Date		Cementing End Date		Wellbore	
11/07/2006				Original Hole - Initial Migration	
Stg #	Description	Top (ftKB)	Btm (ftKB)	Full Return?	
1	Conductor	0.0	38.0	Yes	
Sequence		Fluid Des		Amount (sacks)	Class
Scavenger		5890 lbs Portland Cmt,			

Conductor, 504.0ftKB Proposed? <proposedrun>

Cementing Start Date 11/15/2006		Cementing End Date		Wellbore Original Hole - Initial Migration	
Stg # 1	Description Conductor	Top (ftKB) 38.0	Btm (ftKB) 504.0	Full Return? Yes	
Sequence		Fluid Des		Amount (sacks)	Class
Scavenger					

Surface, 2,499.4ftKB Proposed? <proposedrun>

Cementing Start Date 02/13/2007		Cementing End Date		Wellbore Original Hole - Initial Migration	
Stg # 1	Description Surface	Top (ftKB) 0.0		Btm (ftKB) 2,499.4	Full Return? Yes
Sequence		Fluid Des		Amount (sacks)	Class
Lead		Class 'G'		2,862	

Surface, 2,499.4ftKB Proposed? <proposedrun>

Cementing Start Date		Cementing End Date		Wellbore	
08/20/2009				Original Hole - Initial Migration	
Stg #	Description	Top (ftKB)	Btm (ftKB)	Full Return?	
	Cement Plug	0.0	57.0		
Sequence		Fluid Des		Amount (sacks)	Class

Perforation Data

Stage #	Type	Top Depth (ftKB)	Bottom Depth (ftKB)	Zone

Other In Hole

OD (in)	Des	Top (ftKB)	Btm (ftKB)	ID (in)	Make	Model