


WELL LOCATION CERTIFICATE

THIS MAP DOES NOT REPRESENT A BOUNDARY SURVEY

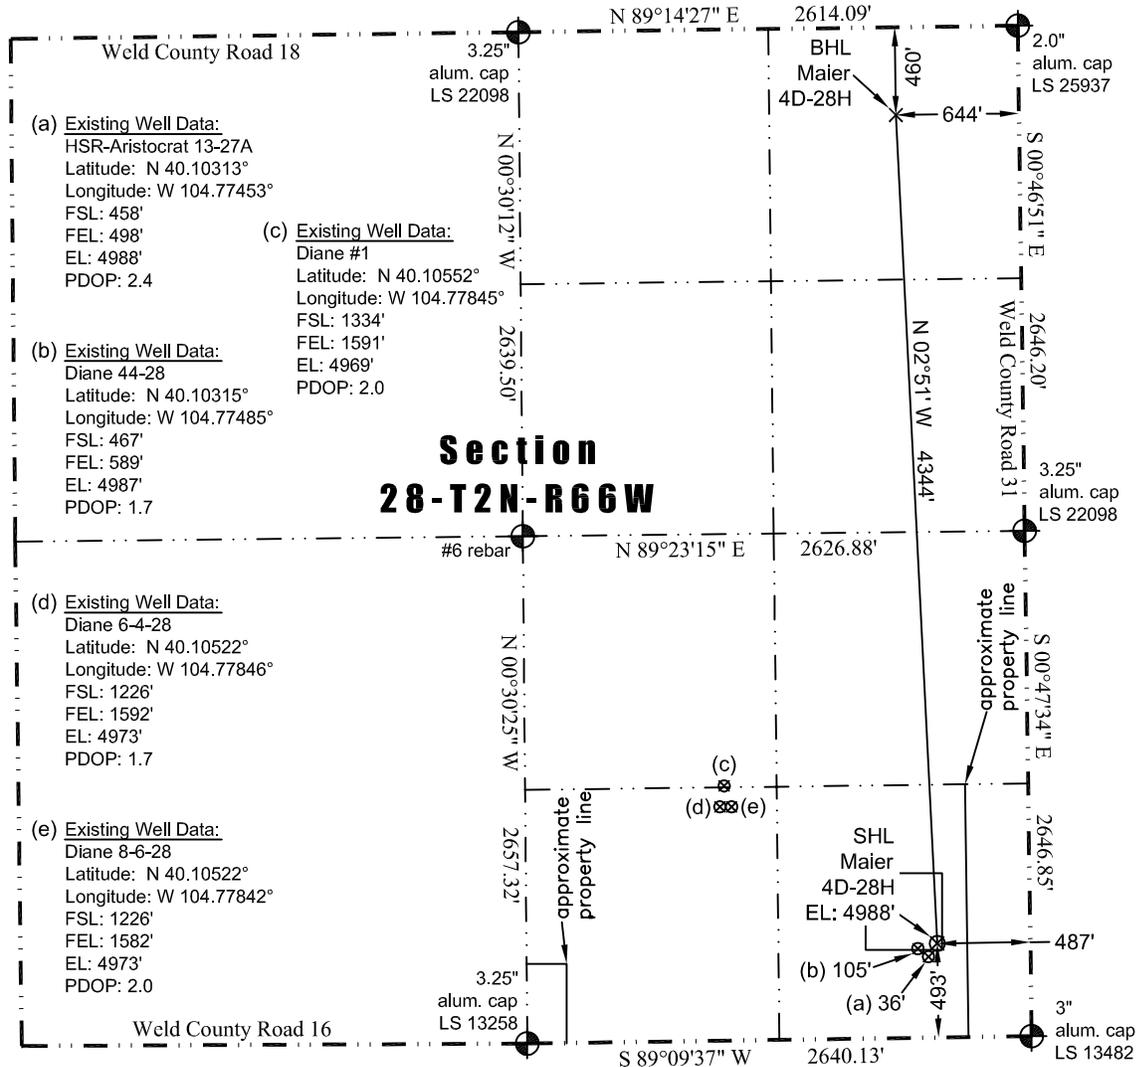

(a) Existing Well Data:

HSR-Aristocrat 13-27A
Latitude: N 40.10313°
Longitude: W 104.77453°
FSL: 458'
FEL: 498'
EL: 4988'
PDOP: 2.4

(b) Existing Well Data:

Diane 44-28
Latitude: N 40.10315°
Longitude: W 104.77485°
FSL: 467'
FEL: 589'
EL: 4987'
PDOP: 1.7

(c) Existing Well Data:

Diane #1
Latitude: N 40.10552°
Longitude: W 104.77845°
FSL: 1334'
FEL: 1591'
EL: 4969'
PDOP: 2.0

(d) Existing Well Data:

Diane 6-4-28
Latitude: N 40.10522°
Longitude: W 104.77846°
FSL: 1226'
FEL: 1592'
EL: 4973'
PDOP: 1.7

(e) Existing Well Data:

Diane 8-6-28
Latitude: N 40.10522°
Longitude: W 104.77842°
FSL: 1226'
FEL: 1582'
EL: 4973'
PDOP: 2.0

Section 28-T2N-R66W

In accordance with a request from Jay Knutson of EnCana Oil & Gas (USA) Inc., JR Land Surveying, LLC has determined the location of the **Maier 4D-28H** well site to be SHL: 493' FSL and 487' FEL, (BHL: 460' FNL and 644' FEL), as measured at ninety (90) degrees from the section lines of Section 28, Township 2 North, Range 66 West, 6th Principal Meridian, Weld County, CO.

Proposed Surface Hole Data:

Latitude: N 40.10323° (BHL: 40.11514°)
Longitude: W 104.77449° (BHL: 104.77514°)
PDOP: 2.5

Nearest:

| | |
|---|---------------------------------|
| Building: 583' northeast | Above Ground Utility: 321' east |
| Public Road: 473' east | Railroad: 9,478' west |
| Property Line: 157' east | Well Window: SHL is 26' inside |
| Existing Well: HSR-Aristocrat 13-27A, 36' southwest | |

I hereby certify that this Well Location Certificate was prepared by me or under my direct supervision on 1/21/2013 for and on behalf of EnCana Oil & Gas (USA) Inc. That it is not a Land Survey Plat or an Improvement Survey Plat and that it is not to be relied upon for establishment of fences, buildings, or other future improvement lines.

Notes:

- 1) Bearings and distances based on NAD 83 Colorado North State Plane Coordinates using RTK GPS observations taken 11/14/12 by operator John Rice.
- 2) Conversion factor to ground (1.0002756760).
- 3) Elevations based on NAVD 88 GPS heights and Geoid 2003 corrections.
- 4) See Location Drawing for visible improvements within 400 of pad site.
- 5) The surface use is a cultivated field.

NOTICE: According to Colorado law you MUST commence any legal action based upon any defect in this W.L.C. within three years after you first discover such defect. In no event may any action based upon any defect in this W.L.C. be commenced more than ten years from this said date of the certification shown hereon.

John Robert McGehee LS#38219
Well: Maier 4D-28H WLC

