


KERR-MCGEE OIL AND GAS ONSHORE LP
HSR-DREYER 5-5
SW NW 5 1S 65W 1,287' FNL 990' FWL
ADAMS, COLORADO
04/17/2013

AREA: S5 ROUTE: S57 Spud: 05/10/1994 WINS No.: 75439 AFE/WO#: 2079447 API#: 0500109223

GL: 5055 KB: 5065 MTD: 8246 TVD: 8246 LOG MD: 8257 PBMD: 8115 PBTVD: 8115

Directions: **HARVEST RD & WCR 2, 1/4 MILE S, E INTO LOCATION. ON SAME LOCATION WITH CDP #51.**

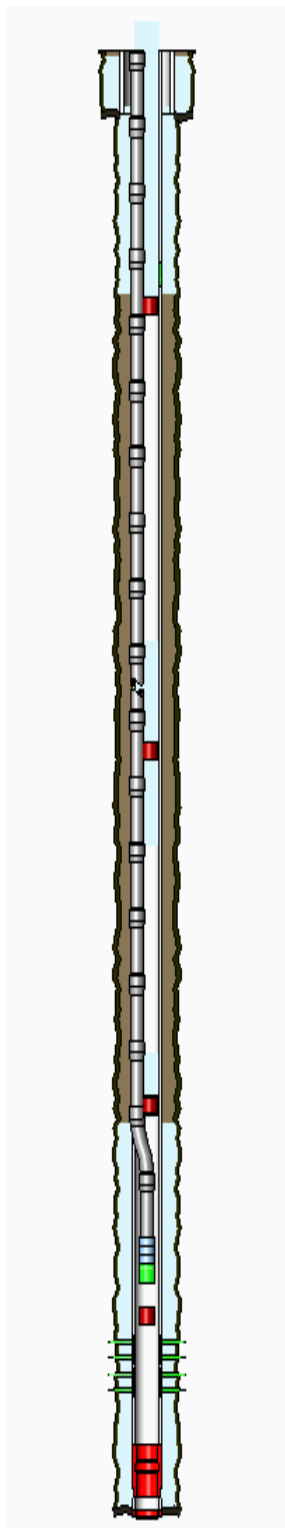

<u>HOLE SECTIONS</u>	<u>Size</u>	<u>Top</u>	<u>Btm</u>	<u>TD Date</u>					
SURFACE	12.25	10	458	05/10/1994					
PRODUCTION	7.88	458	8246	05/16/1994					
<u>TUBULARS</u>	<u>Tool Type</u>	<u>Joints</u>	<u>Size</u>	<u>Weight</u>	<u>Grade</u>	<u>Thread</u>	<u>Top D</u>	<u>Bottom D</u>	
SURFACE CASING	Casing	10	8.63	24	IPSCO		10	444	
PRODUCTION CASING	Casing	34	4.50	11.60	I-70	LT&C	10	1477	
	Cement Stage Too	1	4.50				1477	1480	
	Casing	157	4.50	11.60	I-70	LT&C	1480	8230	
	Casing Float Collar	1	4.50				8230	8231	
	Casing	1	4.50	11.60	I-70	LT&C	8231	8251	
	Casing Guide Shoe	1	4.50				8251	8252	
PRODUCTION TUBING	Tubing	254	2.38	4.70	J-55	External-Ups	10	7732	
	Seating Nipple	1					7732	7733	
	Notched Collar	1					7733	7734	
BRIDGE PLUG	Wellbore Equipment						7900	7902	
CEMENT RETAINER	Wellbore Equipment						6870	6872	
CICR	Wellbore Equipment						4530	4532	
BRIDGE PLUG	Wellbore Equipment						1560	1562	
<u>CEMENT JOBS</u>	<u>Stage</u>	<u>Sacks</u>	<u>Cement Jobs</u>				<u>Top D</u>	<u>Btm D</u>	<u>cbl</u>
SURFACE CASING	STAGE 1	300	NEAT				50	444	No
PRODUCTION CASING	STAGE 2	520	PREMIUM				400	1544	Yes
	STAGE 1	290	PREMIUM				6930	8252	Yes
PRODUCTION CASING	ABANDONMENT PLUC						6575	6901	No
PRODUCTION CASING	ABANDONMENT PLUC						3834	5127	No
PRODUCTION CASING	ABANDONMENT PLUC						0	1560	No
<u>PERFORATIONS</u>	<u>Formation</u>	<u>Zone</u>	<u>Top</u>	<u>Btm</u>	<u>Date</u>	<u>Reason</u>	<u>Comments</u>		
	J SAND		7956	7970	06/03/1994	PRODUCTION			
	J SAND		7984	7986	06/03/1994	PRODUCTION			

Comments: