
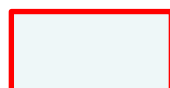


LaSalle 25G-402

Proposed Spacing Unit

S2N2 and N2S2 of Sec. 25 T5N R65W

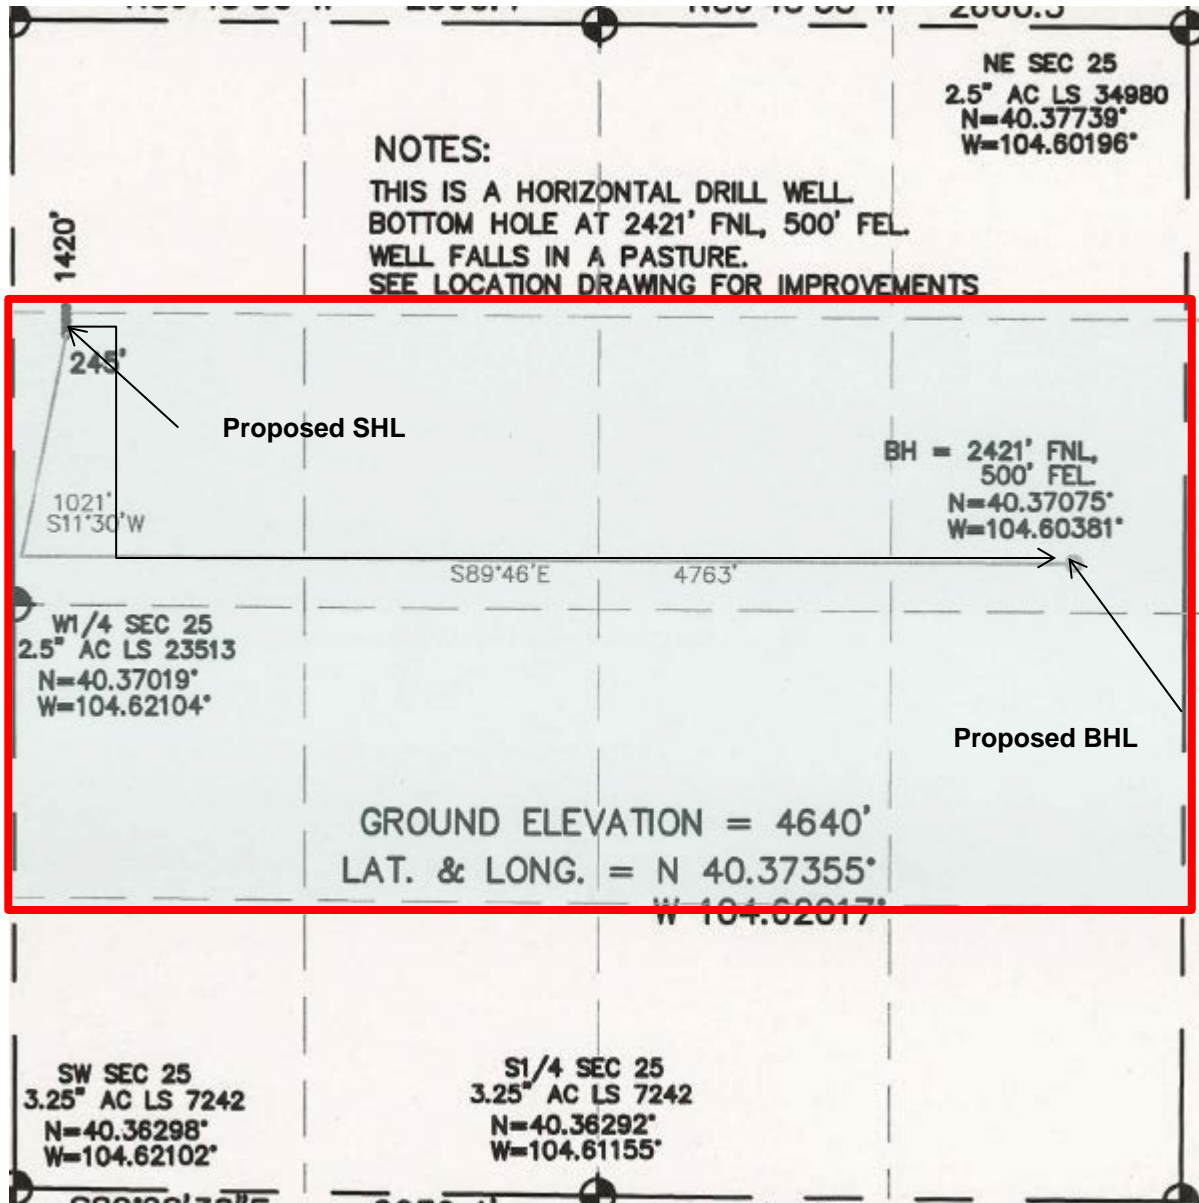

Proposed 320 acre Spacing Unit