


NW Cor. Sec. 32  
Brass Cap

EE3 LLC.


FIGURE #5

LOCATION DRAWING FOR

SPICER #03-32H  
SECTION 32, T7N, R80W, 6th. P.M.  
645' FSL 747' FWL

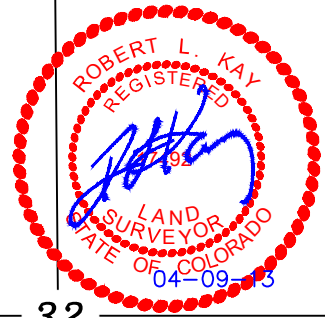

S00°06'19"E  
2645.68' (Meas.)

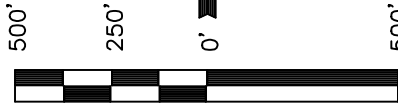

SCALE  
DATE: 07-05-11

DRAWN BY: J.I.  
REVISED: 04-04-13 R.L.

1939 Brass Cap  
0.4' High, T-Post

1/4 Section Line

32

1/16 Section Line

LINE TABLE			
LINE	FEATURE	DIRECTION	LENGTH
L1	POWER LINE	S53°E	353'

S00°27'11"E - 2645.87' (Meas.)

Section Line

1/16 Section Line

SW 1/4

County Road #28

North Park  
Registered  
Herefords

Existing  
Access Road

WEST 747'  
(To Property Line)

S81°W 22.5 Miles  
(To Railroad)

S58°W 2990'  
(To Water Well  
& Building)

SOUTH 341'  
(To Surface  
Water)

L1

OHP

OHP

OHP

Powerline

1939 Brass Cap  
1.0' High, Scattered  
Stones, T-Post

SE Cor. Sec. 32  
Brass Cap 0.6'  
High, N-S Fenceline

T7N  
T6N

1939 Brass Cap  
0.7' High

N89°54'30"E - 2677.17' (Meas.)

Section Line

N89°54'40"E  
2625.84' (Meas.)

#### PLANT COMMUNITY

- ☐ DISTURBED GRASSLAND
- ☐ NATIVE GRASSLAND
- ☐ SHRUB LAND
- ☐ PLAINS RIPARIAN
- ☐ MOUNTAIN RIPARIAN
- ☐ FOREST LAND
- ☐ WETLANDS AQUATIC
- ☐ ALPINE
- ☐ OTHER (Describe): \_\_\_\_\_

#### CURRENT LAND USE

- CROP LAND: ☐ IRRIGATED ☐ DRY LAND ☐ IMPROVED PASTURE ☐ HAY MEADOW ☐ CRP  
NON-CROP LAND: ☐ RANGELAND ☐ TIMBER ☐ RECREATIONAL ☐ OTHER (Describe) \_\_\_\_\_  
SUBDIVIDED: ☐ INDUSTRIAL ☐ COMMERCIAL ☐ RESIDENTIAL \_\_\_\_\_

#### FUTURE LAND USE

- CROP LAND: ☐ IRRIGATED ☐ DRY LAND ☐ IMPROVED PASTURE ☐ HAY MEADOW ☐ CRP  
NON-CROP LAND: ☐ RANGELAND ☐ TIMBER ☐ RECREATIONAL ☐ OTHER (Describe) \_\_\_\_\_  
SUBDIVIDED: ☐ INDUSTRIAL ☐ COMMERCIAL ☐ RESIDENTIAL \_\_\_\_\_

EE3 LLC.

FIGURE #5A

LOCATION DRAWING DETAIL FOR

SPICER #03-32H  
SECTION 32, T7N, R80W, 6th P.M.  
645' FSL 747' FWL



SCALE: 1" = 200'

DATE: 07-05-11

Drawn By: J.I.

REVISED: 04-04-13 R.L.

