


Final Well Report Detailed (graphic)
Well Name: Figure Four 8010XA J10 499

API # 05103101310000	Well Type Gas	Business Unit Southern Rockies	SBU North Piceance	Area Figure Four	Pad	State CO	County/Parish RIO BLANCO
-------------------------	------------------	-----------------------------------	-----------------------	---------------------	-----	-------------	-----------------------------

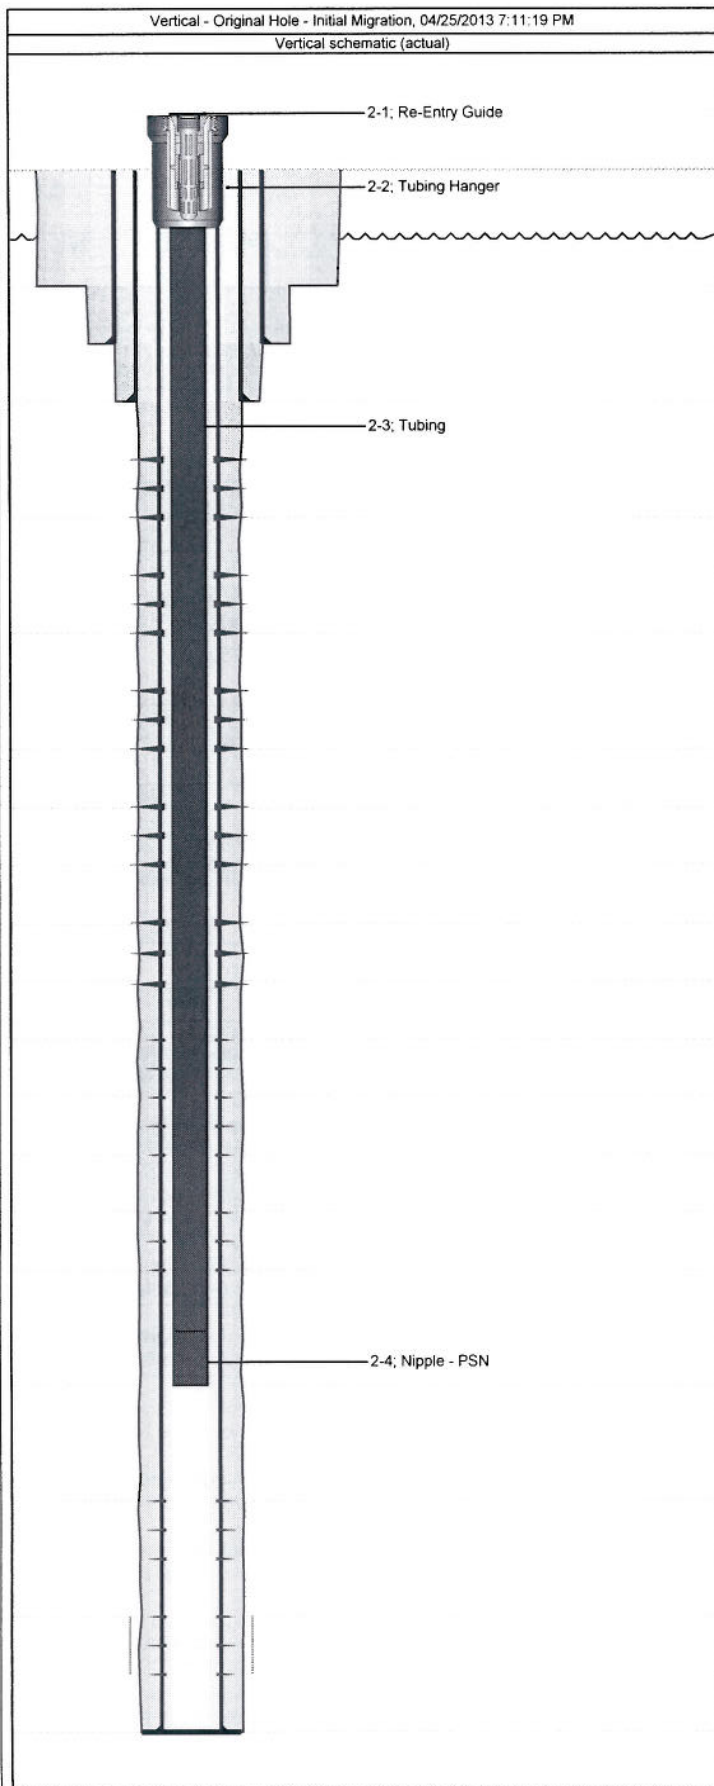


Well Header Setup					
Well Name Figure Four 8010XA J10 499			API # 05103101310000		
Original KB Elevation (ft) 16.40		Ground Elevation (ft)		Spud Date	
Surface Legal Location		Latitude (decimal) (*)		Longitude (decimal) (*)	
Wellbore Sections Setup					
Wellbore Type Original Hole - Initial Migration			Kick Off Depth (ftKB)		VS Dir (*)
Section Des	Hole Size (in)	Act Top (ftKB)	Act Btm (ftKB)		
Conductor	26	0.0	85.0		
Surface	17 1/2	85.0	406.0		
Intermediate	12 1/4	406.0	3,500.0		
Production	8 3/4	3,500.0	9,515.0		
Plug Back Total Depths					
Date	Depth (ftKB)	Method		Com	
08/29/2012	9,515.0				
Casing Data					
Conductor					
Casing Description Conductor			Run Date		Set Depth (ftKB) 85.0
Item Des	OD (in)	ID (in)	Wt (lb/ft)	Grade	Len (ft)
Casing Joints			50.00		85.00
Surface					
Casing Description Surface			Run Date		Set Depth (ftKB) 406.0
Item Des	OD (in)	ID (in)	Wt (lb/ft)	Grade	Len (ft)
Casing Joints	13 3/8	12.615	54.50		406.00
Intermediate					
Casing Description Intermediate			Run Date		Set Depth (ftKB) 3,500.0
Item Des	OD (in)	ID (in)	Wt (lb/ft)	Grade	Len (ft)
Casing Joints	9 5/8	8.835	40.00		3,500.00
Production					
Casing Description Production			Run Date		Set Depth (ftKB) 9,515.0
Item Des	OD (in)	ID (in)	Wt (lb/ft)	Grade	Len (ft)
Casing Joints	5 1/2	4.892	17.00		9,515.00
Cement Data					
Intermediate, 3,500.0ftKB Proposed? No					
Description Intermediate 1 Casing Cement		String Intermediate, 3,500.0ftKB Proposed? No	Wellbore Original Hole - Initial Migration		Type Casing
Stg # 1	Description Intermediate	Top (ftKB) 3,500.0	Btm (ftKB)	Full Return?	
Sequence	Fluid Des	Amount (sacks)	Class		
Tail		1,045			
Production, 9,515.0ftKB Proposed? No					
Description Production Casing Cement		String Production, 9,515.0ftKB Proposed? No	Wellbore Original Hole - Initial Migration		Type Casing
Stg # 1	Description Production	Top (ftKB) 9,515.0	Btm (ftKB)	Full Return?	
Sequence	Fluid Des	Amount (sacks)	Class		
Tail		1,430			
Surface, 406.0ftKB Proposed? No					
Description Surface Casing Cement		String Surface, 406.0ftKB Proposed? No	Wellbore Original Hole - Initial Migration		Type Casing
Stg # 1	Description Surface	Top (ftKB) 406.0	Btm (ftKB)	Full Return?	

Final Well Report Detailed (graphic)

Well Name: Figure Four 8010XA J10 499

API # 05103101310000	Well Type Gas	Business Unit Southern Rockies	SBU North Piceance	Area Figure Four	Pad	State CO	County/Panish RIO BLANCO
-------------------------	------------------	-----------------------------------	-----------------------	---------------------	-----	-------------	-----------------------------

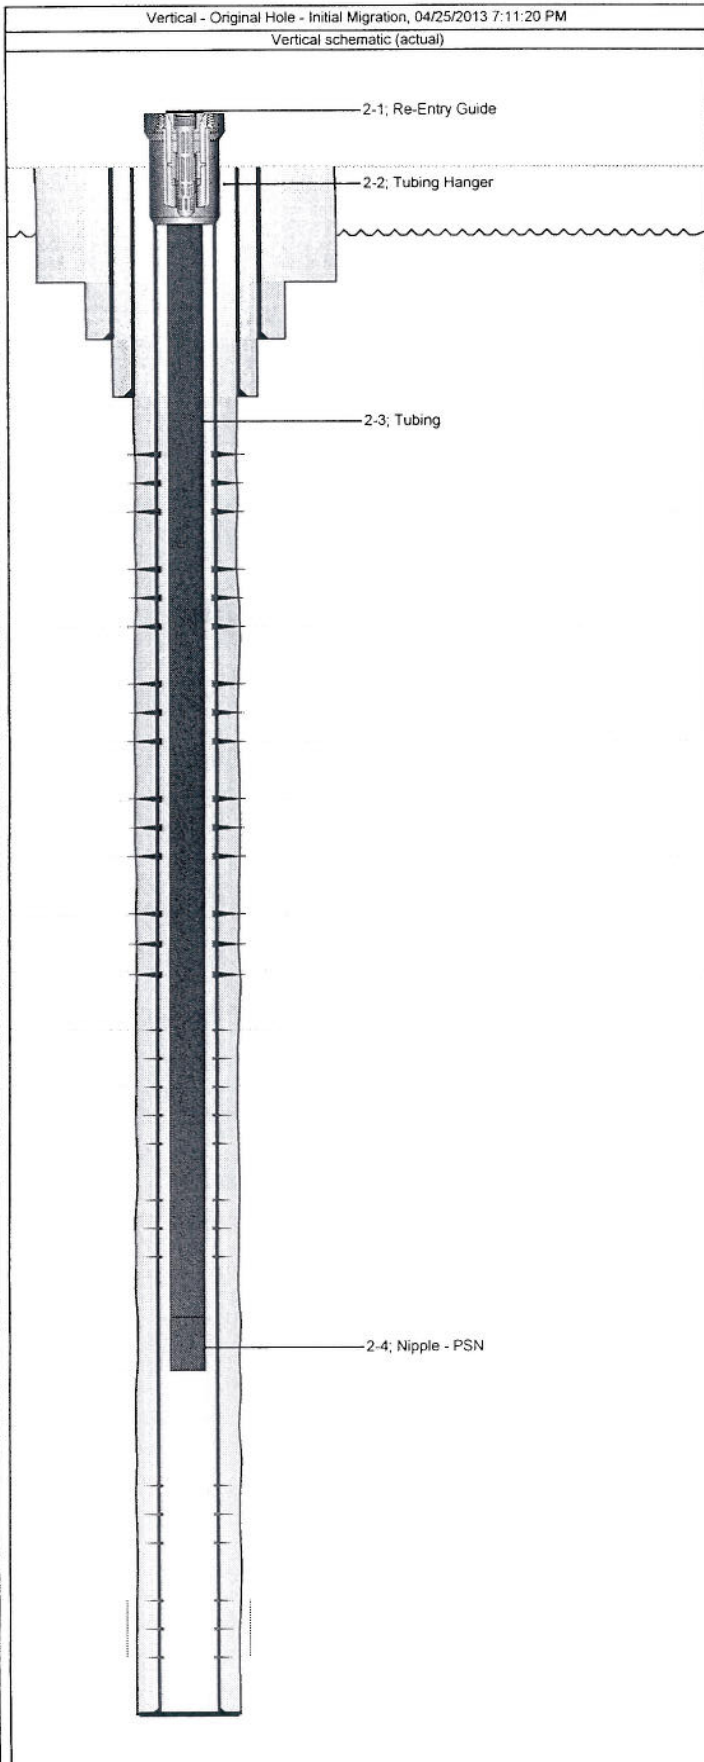


Sequence		Fluid Des		Amount (sacks)	Class
Tail				900	
Conductor, 85.0ftKB Proposed? No					
Description Conductor Cement		String Conductor, 85.0ftKB Proposed? No		Wellbore Original Hole - Initial Migration	Type Casing
Stg # 1	Description Conductor			Top (ftKB) 85.0	Btm (ftKB) Full Return?
Sequence		Fluid Des		Amount (sacks)	Class
Tail				200	
Tubing Data					
Tubing Description Tubing from Migration			Tubing Set Date 07/18/2003		Set Depth (ftKB) 8,379.0
Item Des		OD (in)	ID (in)	Len (ft)	
Tubing		2 3/8		12.00	
Tubing		2 3/8		8,367.74	
Collar		2 3/8		0.23	
Tubing Description Tubing from Migration			Tubing Set Date 08/28/2012		Set Depth (ftKB) 8,293.0
Item Des		OD (in)	ID (in)	Len (ft)	
Re-Entry Guide		3 1/16	2.375	0.01	
Tubing Hanger		7	2.375	1.00	
Tubing		3 1/16	1.995	8,278.91	
Nipple - PSN		3 1/16	1.780	1.40	
				12.00	
Rod Data					
Rod Description		Run Date		Set Depth (ftKB)	
Item Des		OD (in)		Len (ft)	
Zones					
Zone Name Original Migration		Wellbore Original Hole - Initial Migration		Top Depth (ftKB)	Btm (ftKB)
Cur Stat Date 01/09/2002	Current Status Shut-In	Formation(s)			
Perforation Data					
Stage # 10	Type	Top Depth (ftKB) 4,972.0	Bottom Depth (ftKB) 5,386.0	Zone Original Migration, Original Hole - Initial Migration	
Stage # 9	Type	Top Depth (ftKB) 5,622.0	Bottom Depth (ftKB) 5,628.0	Zone Original Migration, Original Hole - Initial Migration	
Stage # 8	Type	Top Depth (ftKB) 5,714.0	Bottom Depth (ftKB) 5,780.0	Zone Original Migration, Original Hole - Initial Migration	
Stage # 7	Type	Top Depth (ftKB) 5,874.0	Bottom Depth (ftKB) 5,882.0	Zone Original Migration, Original Hole - Initial Migration	
Stage # 6	Type	Top Depth (ftKB) 5,938.0	Bottom Depth (ftKB) 5,944.0	Zone Original Migration, Original Hole - Initial Migration	
Stage # 5	Type	Top Depth (ftKB) 6,620.0	Bottom Depth (ftKB) 6,673.0	Zone Original Migration, Original Hole - Initial Migration	
Stage # 4	Type	Top Depth (ftKB) 6,673.0	Bottom Depth (ftKB) 6,683.0	Zone Original Migration, Original Hole - Initial Migration	
Stage # 3	Type	Top Depth (ftKB) 7,550.0	Bottom Depth (ftKB) 7,560.0	Zone Original Migration, Original Hole - Initial Migration	
Stage # 2	Type	Top Depth (ftKB) 8,584.0	Bottom Depth (ftKB) 8,732.0	Zone Original Migration, Original Hole - Initial Migration	
Stage # 1	Type	Top Depth (ftKB) 9,160.0	Bottom Depth (ftKB) 9,170.0	Zone Original Migration, Original Hole - Initial Migration	

Final Well Report Detailed (graphic)

Well Name: Figure Four 8010XA J10 499

API # 05103101310000	Well Type Gas	Business Unit Southern Rockies	SBU North Piceance	Area Figure Four	Pad	State CO	County/Parish RIO BLANCO
-------------------------	------------------	-----------------------------------	-----------------------	---------------------	-----	-------------	-----------------------------

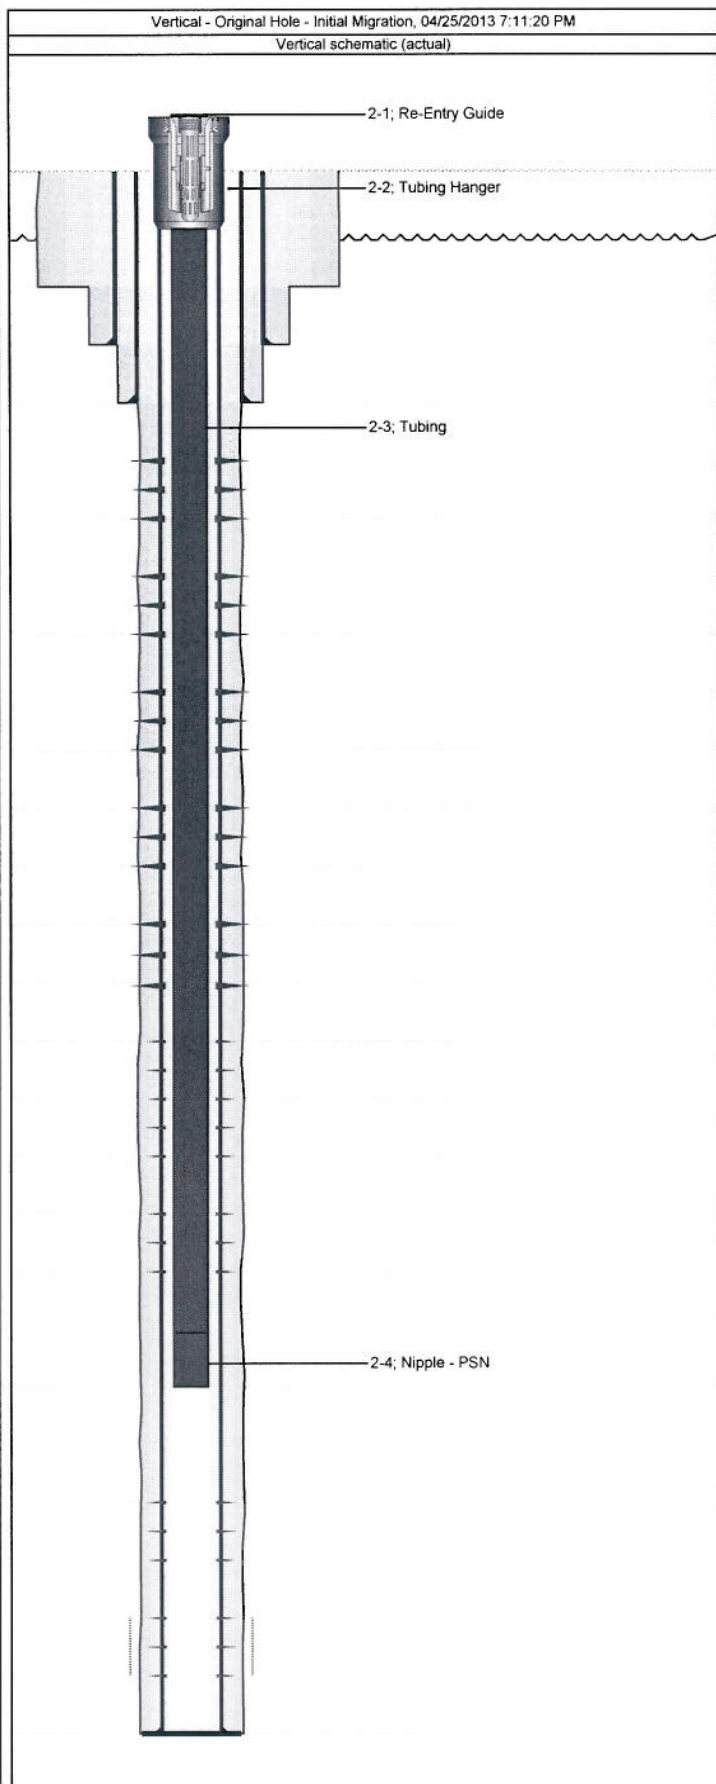

Other In Hole						
OD (in)	Des	Top (ftKB)	Btm (ftKB)	ID (in)	Make	Model
	CFP	8,530.0				

Wellhead Description					
Install Date	Type	Make	Size (in)	WP (psi)	
Make	Model	Section	Top Sz (in)	Btm Sz (in)	WP (psi)

Schematic Annotations	
Depth (ftKB)	Annotation

General Notes	
Date	Com