

Well

Operator

Location

County

State

Field

Footages

Dowdy 8-6-10

EnCana Oil & Gas (USA) Inc.

NESE Section 10-T2N-R65W

WELD

Colorado


Wattenberg

2427' FS & 202' FEL

Spud Date: 09-30-12

Log Tops

Sussex	4376'
Niobrara	6987'
Codell	7269'
J Sand	7725'

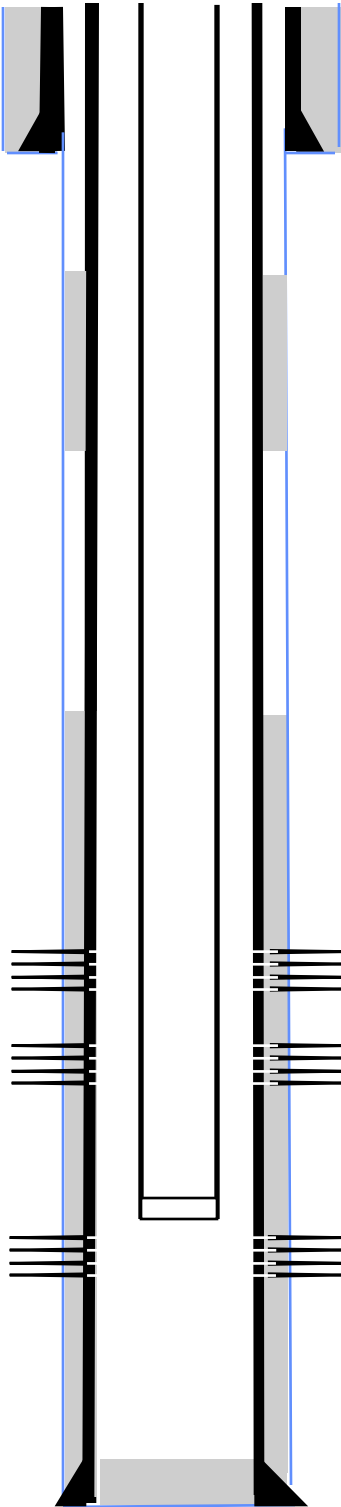

**Surface Casing and Cement**  
8 5/8" , landed @ 918',cemented with 430 sxs

**Main Hole**  
7-7/8" to TD

**Production Casing and Cement**  
4-1/2" , landed @ 7865',cemented with 668 sxs

Perf'd the Niobrara 7052' – 7062' @ 4 spf  
Frac'd the Niobrara with 250,140# 20/40 sand and 88,872 gals  
SLF. 01-07-13

**CIBP**  
Set @ 7120'.  
Drilled out on 01-09-13

Perf'd the Codell from 7271' – 7285' @ 3 spf  
Frac'd the Codell with 242,740# 20/40 sand and 77,784 gal SLF.  
12-22-12

**CFP**  
Set 7335'.  
Drilled out on 01-09-13

**Production Tubing**  
2-3/8" tubing, set @ 7690'

Perf'd the J Sand from 7727' - 7770'@ 2 spf  
Frac'd the J sand with 248,980# 20/40 sand with 117,894 gals  
SLF. 12-20-12

7875' — Driller's TD