

Well

Operator

Location

County

State

Field

Footages

Dowdy 44-10

EnCana Oil & Gas (USA) Inc.

NESE Section 10-T2N-R65W

WELD

Colorado


Wattenberg

2437' FSL & 202' FEL

Spud Date: 10-05-12

Log Tops

Sussex	4556'
Niobrara	7220'
Codell	7506'
J Sand	7961'

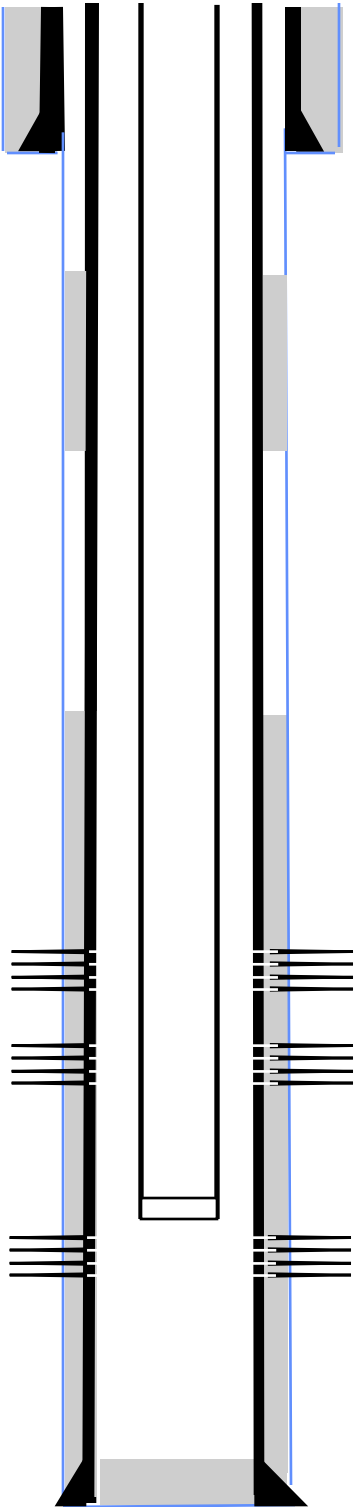

Surface Casing and Cement
8 5/8" , landed @ 907',cemented with 370 sxs

Main Hole
7-7/8" to TD

Production Casing and Cement
4-1/2" , landed @ 8111',cemented with 450 sxs

CBP
Drilled out on 01-11-13

Perf'd the Niobrara from 7274' – 7286' @ 4 spf
Frac'd the Niobrara with 250,800# 20/40 sand with 91,476 gals SLF. 12-22-12

CFP
Set @ 7350' 12-22-12.
Drilled out on 01-11-13

Perf'd the Codell from 7508' – 7522' @ 3 spf
Frac'd the Codell with 121,000# 20/40 sand with 51,660 gals SLF. 12-22-12

CFP
Set @ 7572'. 12-20-13
Drilled out on 01-11-13

Production Tubing
2-3/8" tubing, set @7916'

Perf'd the J Sand 7962' – 8001' @ 2 spf
Frac'd the J Sand with 252,120# 20/40 sand with 114,492 gals SLF. 12-20-12

8120' — Driller's TD