Company:	**US ROCKIES REGION**			**Site:**	**SAKATA ROBERT GU #2**
Project:	**COLORADO-WELD-NAD83-UTM13**			**Common Well Name:**	**SAKATA ROBERT GU #2**
API No:	0512309989	Datum:	DFE	Section: 6	Div of Quarter Section: SE
Latitude:	40.170030°	Elevation:	0.0usft	Township: 2 N	Div of Section: NW
Longitude:	-104.824339°	Ground:		Range: 66 W	

Casing Information	Casing Size & Weight	Cement Fluid (sacks)	Cement Depths (ft)	Schematic (5/1/2013)	Hole Size (in)	MD / PBMD (usft)	Perforation Intervals (usft)
SURFACE CASING - Set @ 587.0usft	8.625in, 24.00ppf	LEAD, REGULAR, 400	11 (TOC) 598	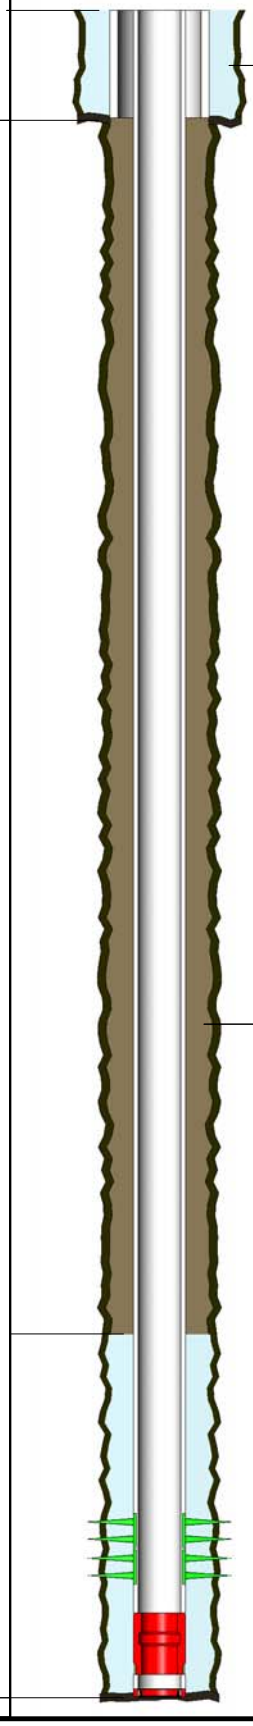	12.250		
PRODUCTION CASING - Set @ 7, 958.0usft	4.500in, 10.50ppf	LEAD, 50/50 POZ-MIX, 250	7089 (TOC)		7.875		7,782 - 7,800 - J SAND 7,808 - 7,846 - J SAND
	4.500in, 10.50ppf		7960			MD: 7,960 PBMD: 7,924	