Company:	**US ROCKIES REGION**		**Site:**	**ENCORE 3-12 PAD**		
Project:	**COLORADO-LARIMER**		**Common Well Name:**	**ENCORE 3-12**		
API No:	0506906425	Datum: RKB	Section: 12		Div of Quarter Section:	NE
Latitude:	40° 25' 12.677 N	Elevation: 4,995.0usft	Township: 5	N	Div of Section:	NW
Longitude:	104° 57' 17.669 W	Ground: 4,979.0usft	Range: 68	W		

Casing Information	Casing Size & Weight	Cement Fluid (sacks)	Cement Depths (ft)	Schematic (2/21/2012)	Hole Size (in)	MD / PBMD (usft)	Perforation Intervals (usft)
SURFACE CASING - Set @ 969.4usft	8.625in, 24.00ppf	LEAD, TYPE 3, 610	16 (TOC) 652 (TOC) 969	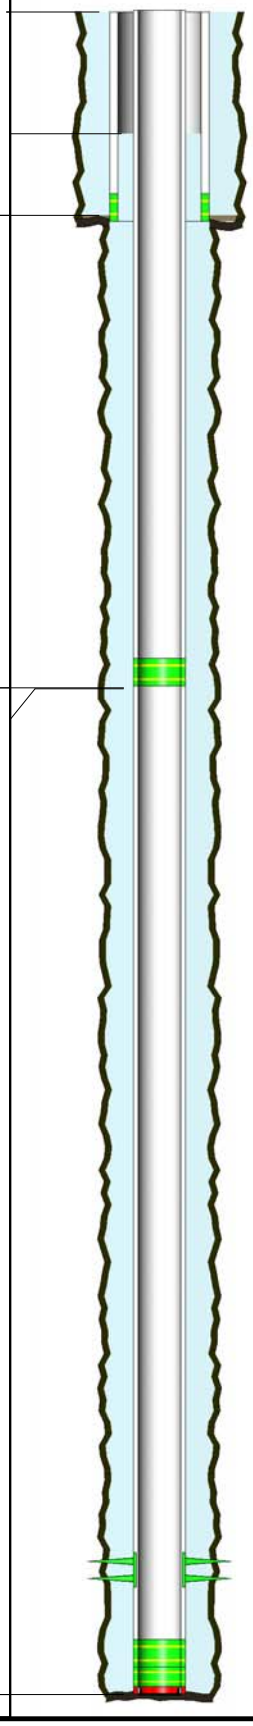			
PRODUCTION CASING - Set @ 7, 921.6usft	4.500in, 11.60ppf 4.500in, 11.60ppf	LEAD, ECONOCEM, 450 TAIL, FRACCEM, 250 LEAD, ECONOCEM, 300 TAIL, TYPE 3, 50	3265 3270 (TOC) 7921			MD: 7,878 PBMD: 7, 895	7,786 - 7,824 - J SAND