

DALEY LAND SURVEYING, INC.


PARKER, CO. 80134

303 953 9841

PRODUCTION FACILITY LOCATION DRAWING

SHABLE FEDERAL PC AB15-66-1HN TANK

SECTION 14, TOWNSHIP 7 NORTH, RANGE 64 WEST OF THE 6TH PRINCIPAL MERIDIAN

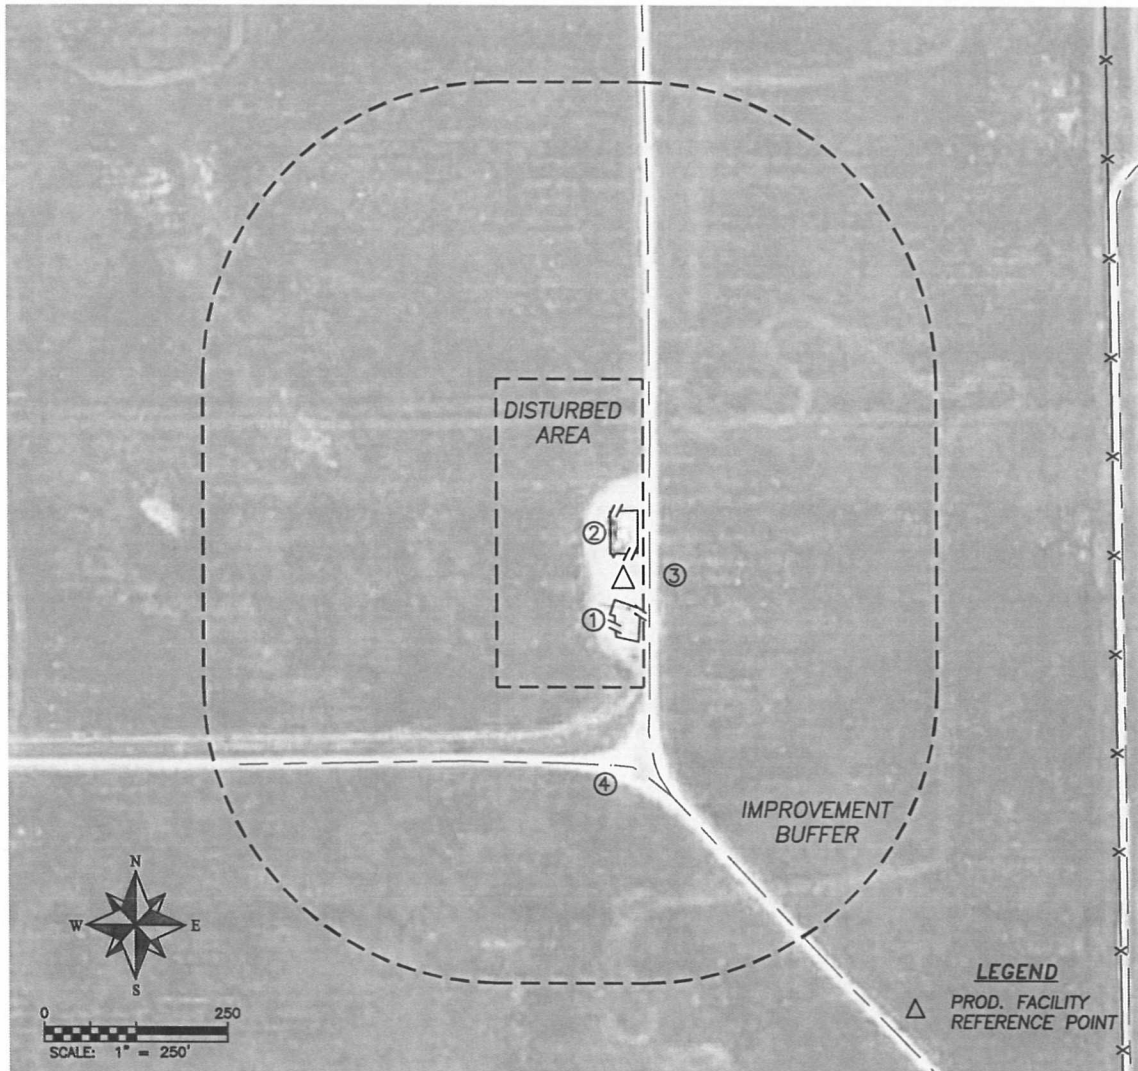

REFERENCE POINT LOCATION:

LATITUDE: N40.57582°
LONGITUDE: W104.50956°
ELEV.: 4833'
PDOP.: 2.1
FOOTAGE: 1720' FNL, 702' FEL
QTR/QTR: SE4/NE4
DATE: 11/16/2012

ASSOCIATED EXISTING WELLS:

SHABLE 14-11, 22, 23, 24, 25

ASSOCIATED NEW WELLS:

SHABLE FEDERAL
PC AB15-66-1HN

DISTANCE TO NEAREST:

BUILDING: 3750'± NE
PUBLIC ROAD: 5280'+
OVERHEAD UTILITY: 5280'+
RAILROAD: 5280'+
PROP. LINE: 702'± E

IMPROVEMENTS

| | |
|---------------------|---------|
| 1. PROD. EQUIP.: | 30'± S |
| 2. PROD. TANKS: | 35'± N |
| 3. WELL ACCESS RD.: | 35'± E |
| 4. WELL ACCESS RD.: | 250'± S |