

KERR-MCGEE OIL AND GAS ONSHORE LP

SNELLA 38-36

SW SW 31 3N 66W 44S FSL 475' FWL

WELD, COLORADO

05/07/2013

AREA: S4

ROUTE: S46 Spud: 07/09/2008

WINS No.: 93281

AFE/WO#: 88350685

API#: 0512326964

GL: 4821

KB: 4833

MTD: 7970


TVD: 7915

LOG MD: 7964

PBMD: 7926

PBTVD: 7870

Directions: HWY 85 & WCR 26; WEST 1/2 MILE; NORTH INTO

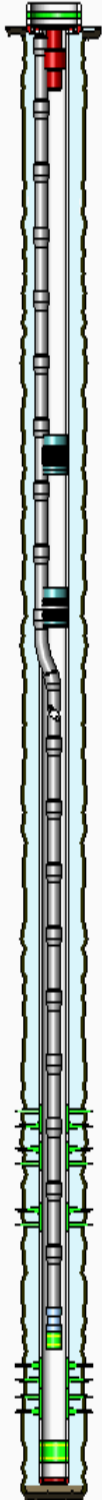

<u>HOLE SECTIONS</u>	<u>Size</u>	<u>Top</u>	<u>Btm</u>	<u>TD Date</u>					
SURFACE	12.25	12	910	07/09/2008					
PRODUCTION	7.88	902	7970	07/14/2008					
<u>TUBULARS</u>	<u>Tool Type</u>	<u>Joints</u>	<u>Size</u>	<u>Weight</u>	<u>Grade</u>	<u>Thread</u>	<u>Top D</u>	<u>Bottom D</u>	
SURFACE CASING	Casing	19	8.63	24.00	J-55	STC	12	856	
	Baffle	1	8.63				856	856	
	Casing	1	8.63	24.00	J-55	STC	856	901	
	Casing Guide Shoe	1	8.63				901	902	
PRODUCTION CASING	Casing	182	4.50	11.60	I-80	LT&C	12	7926	
	Latch Down Baffle	1	4.50				7926	7926	
	Casing	1	4.50	11.60	I-80	LT&C	7926	7954	
	Casing Float Shoe	1	4.50				7954	7956	
PRODUCTION TUBING	Tubing	246	2.38	4.70	J-55	External-Ups	12	7757	
	Seating Nipple	1	2.38				7757	7758	
	Notched Collar	1	2.38				7758	7759	
BRIDGE PLUG	Bridge Plug	1	4.50				4410	4414	
BRIDGE PLUG	Bridge Plug	1	4.50				4535	4539	
PRODUCTION TUBING	Wellbore Equipment	128	2.38		J-55		0	4034	
	Wellbore Equipment	1	3.75				4034	4036	
	Wellbore Equipment	1	2.38				4036	4037	
<u>CEMENT JOBS</u>	<u>Stage</u>	<u>Sacks</u>	<u>Cement Jobs</u>				<u>Top D</u>	<u>Btm D</u>	<u>cbl</u>
SURFACE CASING	PRIM CMT 1ST STAGE	375	LEAD	SWIFTCEM - HOT			12	902	No
PRODUCTION CASING	PRIM CMT 1ST STAGE	128	SPACER	POZZOLAN W/ BENTONITE			3380	3502	Yes
	PRIM CMT 1ST STAGE	550	LEAD	65/35 POZ-MIX			3502	6701	Yes
	PRIM CMT 1ST STAGE	220	TAIL	50/50 POZ-MIX			6701	7956	Yes
--None--	ONE INCH JOB						270	3391	Yes
<u>PERFORATIONS</u>									
<u>Formation</u>	<u>Zone</u>	<u>Top</u>	<u>Btm</u>	<u>Date</u>	<u>Reason</u>	<u>Comments</u>			
NIOBRARA	A	7126	7130	09/11/2008	PRODUCTION	3 SPF			
NIOBRARA	B	7176	7192	09/11/2008	PRODUCTION	3 SPF			
CODELL		7358	7374	09/09/2008	PRODUCTION	3 SPF			
J SAND		7802	7814	11/22/2010	PRODUCTION				
J SAND		7823	7843	11/22/2010	PRODUCTION				

Comments: