

KERR-MCGEE OIL AND GAS ONSHORE LP

DEVON 25-8

NW SE 8 3N 66W 1,989' FSL 2,028' FEL

WELD,COLORADO

05/07/2013

AREA: N3

ROUTE: N31

Spud: 08/18/2006

WINS No.: 77395

AFE/WO#: 88350691

API#: 0512324065

GL: 4870

KB: 4882

MTD: 8100


TVD: 8100

LOG MD:

PBMD: 8055

PBTVD: 8054

Directions: WCR 29 & WCR 36, S 1/2, W INTO

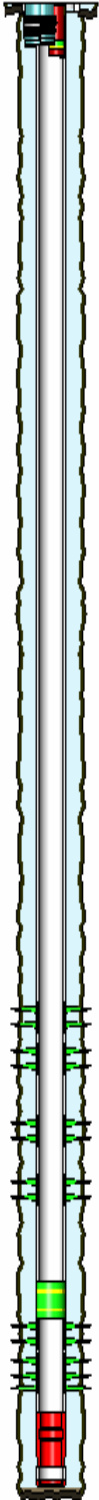

<u>HOLE SECTIONS</u>		<u>Size</u>	<u>Top</u>	<u>Btm</u>	<u>TD Date</u>			
SURFACE		12.25	12	863	08/19/2006			
PRODUCTION		7.88	853	8100	08/21/2006			
<u>TUBULARS</u>	<u>Tool Type</u>	<u>Joints</u>	<u>Size</u>	<u>Weight</u>	<u>Grade</u>	<u>Thread</u>	<u>Top D</u>	<u>Bottom D</u>
SURFACE CASING								
	Casing	19	8.63	24.00	J-55	STC	12	853
PRODUCTION CASING								
	Casing	192	4.50	11.60	I-80	LTC	12	8055
	Casing Float Collar	1	4.50				8055	8056
	Casing	1	4.50	11.60	I-80	LTC	8056	8069
	Casing Guide Shoe	1	4.50				8069	8070
SAND PLUG								
	Sand Plug		4.50				7738	7938
BRIDGE PLUG								
	Bridge Plug	1	4.50				12	4361
BRIDGE PLUG								
	Bridge Plug	1	4.50				12	4485
Kill string								
	Wellbore Equipment	126	2.38		J-55		12	4012
	XN Profile Nipple	1	2.38				4012	4013
	Wellbore Equipment	1	2.38				4013	4014
<u>CEMENT JOBS</u>	<u>Stage</u>	<u>Sacks</u>	<u>Cement Jobs</u>			<u>Top D</u>	<u>Btm D</u>	<u>cbl</u>
SURFACE CASING								
	LEAD	600	LEAD	NEAT		12	853	No
PRODUCTION CASING								
	LEAD	210	LEAD	LITE		3760	4928	Yes
	MIDDLE	125	MIDDLE	LITE		4928	6760	Yes
	TAIL	250	TAIL	50/50 POZ-MIX		6760	8070	Yes
PRODUCTION CASING								
	ONE INCH JOB					426	3760	No
<u>PERFORATIONS</u>								
<u>Formation</u>	<u>Zone</u>	<u>Top</u>	<u>Btm</u>	<u>Date</u>	<u>Reason</u>	<u>Comments</u>		
NIOBRARA	A	7216	7232	09/05/2006	PRODUCTION	3 SPF		
NIOBRARA	B	7264	7280	09/05/2006	PRODUCTION	3 SPF		
NIOBRARA	C	7399	7419	09/05/2006	PRODUCTION	1 SPF		
CODELL		7500	7518	09/01/2006	PRODUCTION	3 SPF		
J SAND		7938	7948	07/29/2008	PRODUCTION	2 SPF		
J SAND		7960	7975	07/29/2008	PRODUCTION	1 SPF		
J SAND		7975	8000	07/29/2008	PRODUCTION	1 SPF		

Comments: