


Griffiths 4-17HZ Pad

- Move the 34N BHL to 250'FWL (inside current spacing unit)
- Move the 13C BHL to 710' FWL (inside current spacing unit)
- Drop the 13N well
- Move the 35C SHL to the current 13N SHL
 - Drop the 35C SHL from the pre set rig
- Move the 35C BHL to 1190' FWL (inside current spacing unit)
- Change the 37C to a NIO well = 37N

Permitted Surface



New Surface

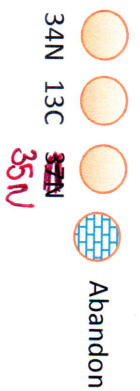

Abandon

