

Well

Operator

Location

County

State

Field

Footages

DOWDY 4-6-10

EnCana Oil & Gas (USA) Inc.

NESE Section 10-T2N-R65W

WELD

Colorado

Wattenberg

2447' FSL; 202' FEL

Spud Date: 10-11-2012

TD Date: 10-14-2012

Log Tops

Sussex

4702'

Niobrara

7491'

Codell


7745'

J Sand

8202'

Production Tubing

2-3/8" tubing, set @ 8166'

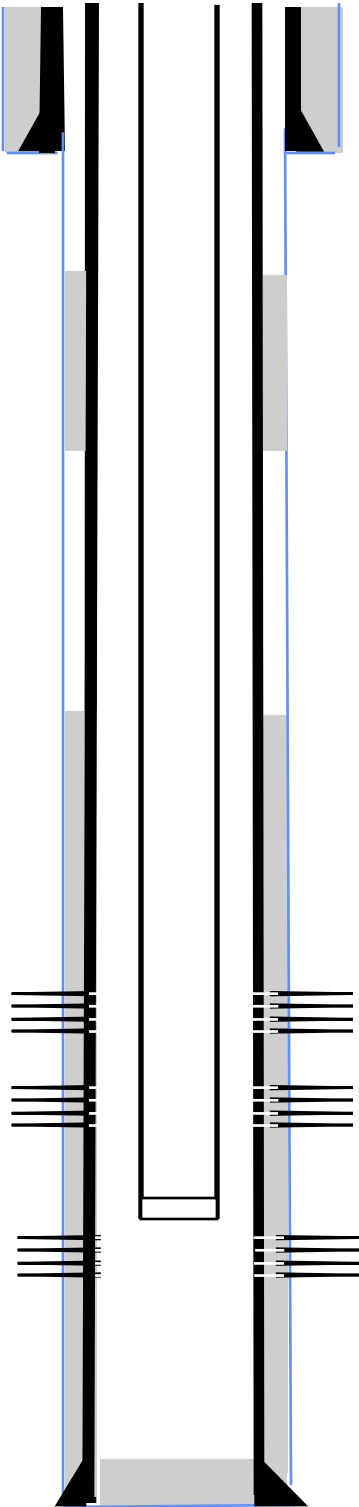

Surface Casing and Cement

8 5/8" , landed @ 921',cemented with 375 sxs

Main Hole

7-7/8" to TD

Production Casing and Cement

4-1/2" , landed @ 8347',cemented with 740 sxs

CBP

Set @ 7400'. 01-12-13

Drilled out on 01-18-13

Perf'd the Niobrara from 7547' – 7599' @ 4 jspf

Frac'd the Niobrara with 260,300# 20/40 sand with 93,324 gals SLF. 12-23-12

CFP

Set @ 7609'. 12-22-12'

Drilled out on 01-28-13

Perf'd the Codell from 7747' – 7761' @ 3 jspf

Frac'd the Codell with 240,080# 20/40 sand and 109,452 gals SLF. 12-21-12

CFP

Set @ 7840'. 12-20-12

Drilled out on 01-18-12

Perf'd the J Sand from 8204' – 8249' @ 2, 3 jspf

Frac'd the J Sand with 249,000# 20/40 sand with 131,292 gals SLF. 12-19-12

8362'

—

Driller's TD