

Well

Operator

Location

County

State

Field

Footages

DOWDY 8-4-10

EnCana Oil & Gas (USA) Inc.

NESE Section 10-T2N-R65W

WELD

Colorado

Wattenberg


2457' FSL; 202' FEL

Spud Date: 10-16-2012

TD Date: 10-19-2012

Log Tops

Sussex	4311'
Niobrara	6854'
Codell	7137'
J Sand	7589'

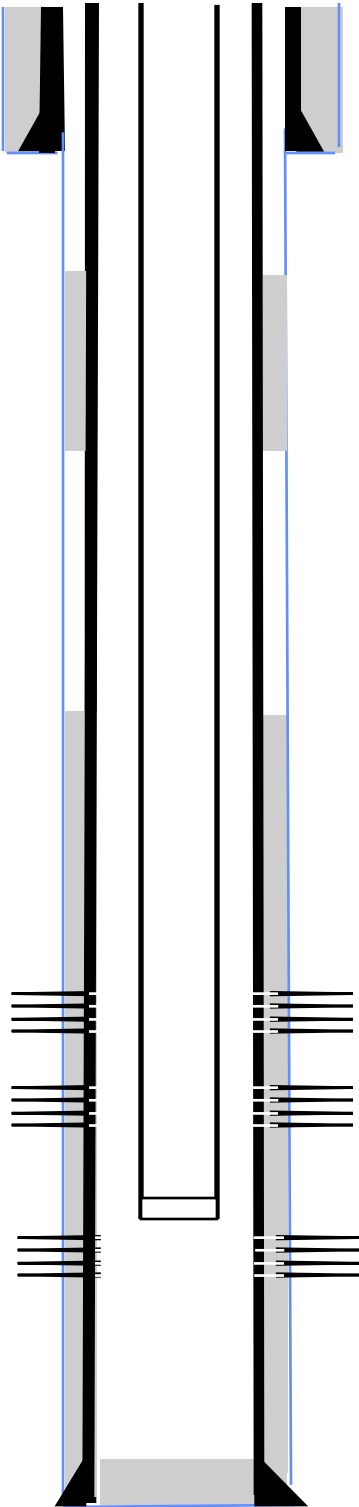

Surface Casing and Cement
8 5/8", landed @ 919', cemented with 350 sxs

Main Hole
7-7/8" to TD

Production Casing and Cement
4-1/2", landed @ 7765', cemented with 623 sxs

CBP
Set @ 7750. 01-18-13
Drilled out on 01-20-13

Perf'd the Niobrara from 6910' – 6922' @ 4 jspf
Frac'd the Niobrara with 250,000# 20/40 sand with 87,822 gals SLF. 12-21-12

CFP
Set @ 6922'. 12-21-12'
Drilled out on 01-20-13

Perf'd the Codell from 7140' – 7154' @ 3 jspf
Frac'd the Codell with 249,520# 20/40 sand with 78,624 gals SLF. 12-21-12

CFP
Set @ 7198'. 12-19-12
Drilled out on 01-20-12

Production Tubing
2-3/8" tubing, set @ 7561'

Perf'd the J Sand from 7592' – 7633' @ 2, 3 jspf
Frac'd the J Sand with 251,400# 20/40 sand with 131,628 gals SLF. 12-19-12

7780' — Driller's TD