

Well

Operator

Location

County

State

Field

Footages

DOWDY 8-2-10

EnCana Oil & Gas (USA) Inc.

NENE Section 10-T2N-R65W

WELD

Colorado

Wattenberg


1114' FNL; 1102' FEL

Spud Date: 10-20-2012

TD Date: 10-23-2012

Log Tops

Sussex	4364'
Niobrara	6994'
Codell	7257'
J Sand	7717'

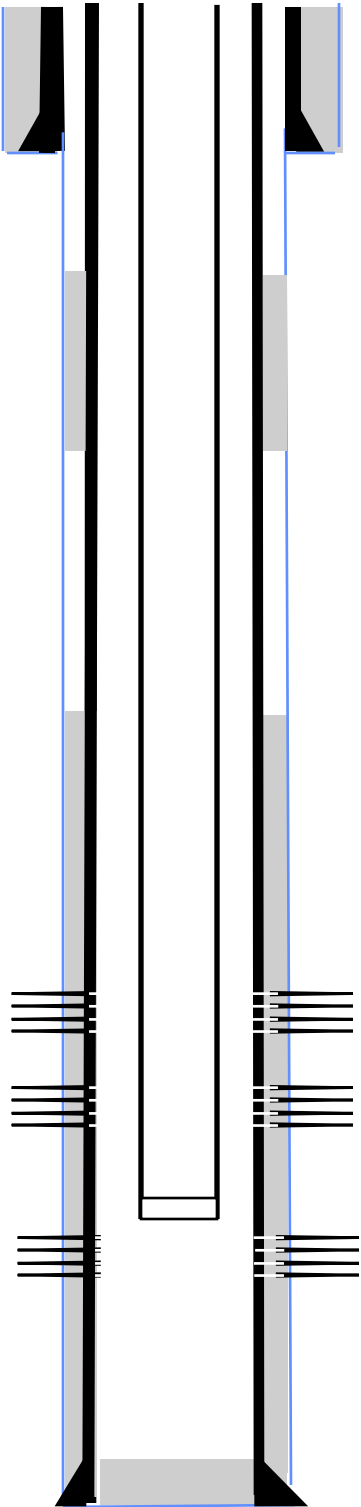

Surface Casing and Cement
8 5/8", landed @ 921', cemented with 350 sxs

Main Hole
7-7/8" to TD

Production Casing and Cement
4-1/2", landed @ 7868', cemented with 640 sxs

CBP
Set @ 6935'. 01-05-13
Drilled out on 01-07-13

Perf'd the Niobrara from 7029' – 7041' @ 4 spf
Frac'd the Niobrara with 251,960# 20/40 sand with 87,948 gals SLF. 12-14-12

CFP
Set @ 7100'. 12-14-12
Drilled out on 01-07-13

Perf'd the Codell from 7258' - 7272' @ 3 jspf
Frac'd the Codell with 250,140# 20/40 sand with 77,616 gals SLF. 12-14-12

CFP
Set @ 7322'. 12-13-12
Drilled out on 01-07-13

Production Tubing
2-3/8" tubing, set @ 7702'

Perf'd the J Sand from 7721' – 7733', 7749' – 7762' @ 2 spf
Frac'd the J Sand 250,000# 20/40 sand with 113,652 gals SLF. 12-13-12

7883' — Driller's TD