


# WELL LOCATION CERTIFICATE

SECTION: 9  
TOWNSHIP: 9N  
RANGE: 58W


**APPROVED**  
By tylerporter at 2:20 pm, 4/15/13

THIS MAP DOES NOT REPRESENT A BOUNDARY SURVEY

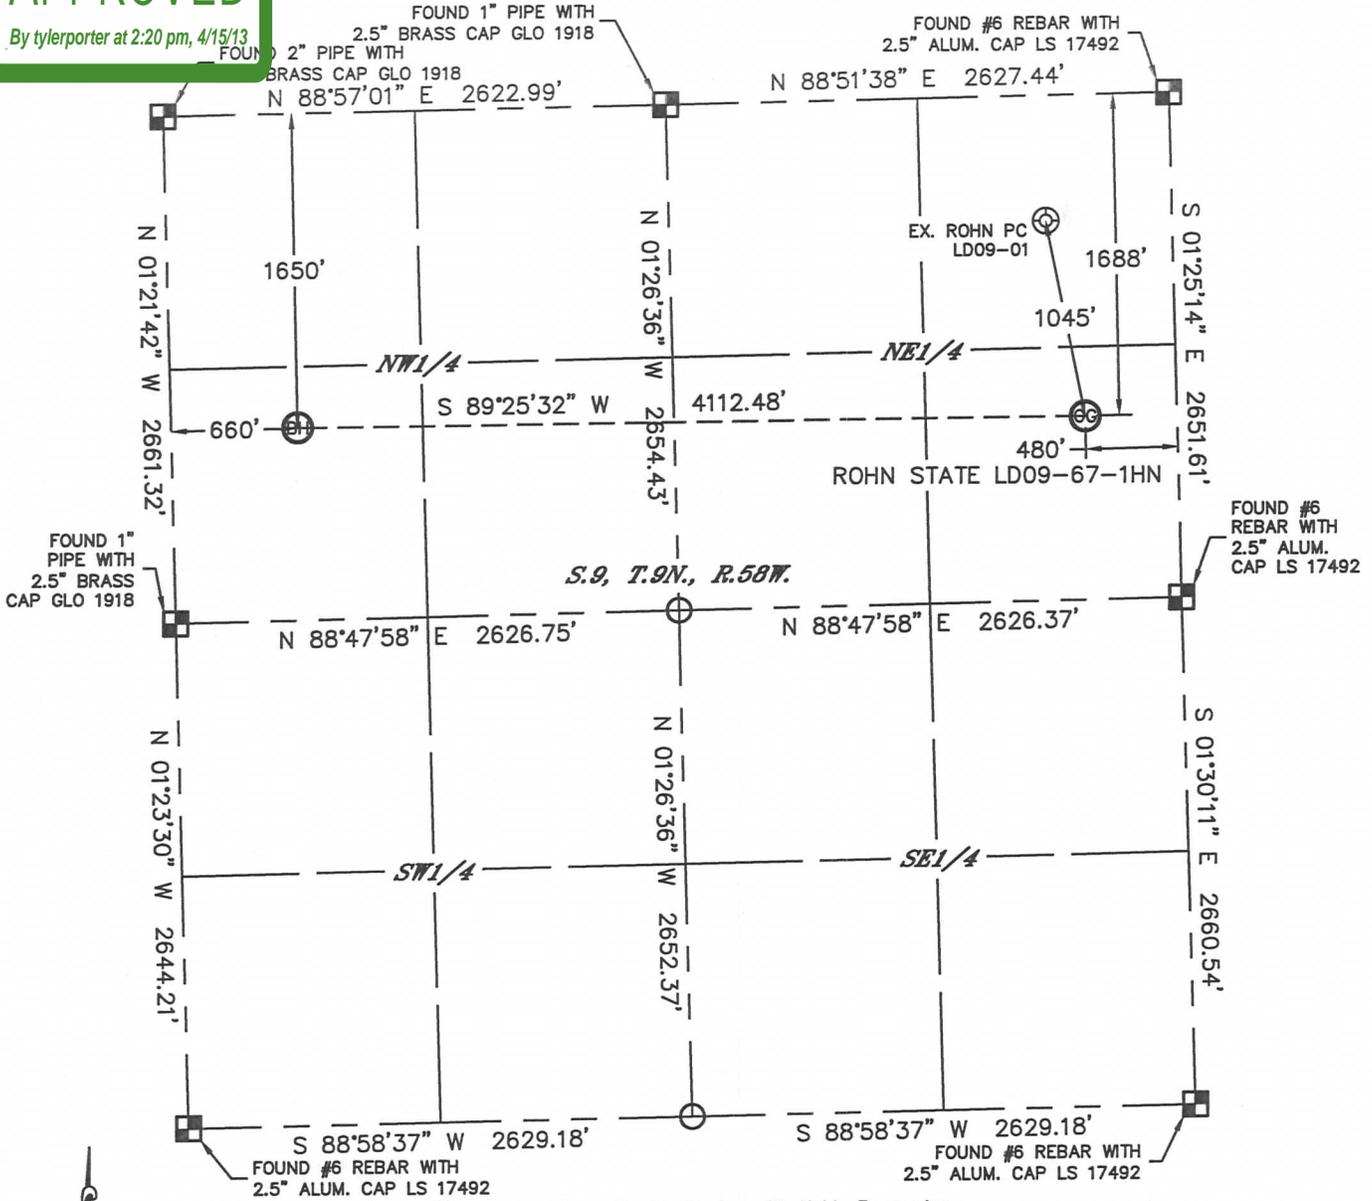

In accordance with a request from Derrick Worden with Noble Energy Inc. Lat40°, Inc. has determined the surface location of the ROHN STATE LD09-67-1HN to be 1688' from the NORTH line and 480' from the EAST line and the bottom hole to be 1650' from the NORTH line and 660' from the WEST line as measured at right angles from the section lines of Section 9, Township 9 North, Range 58 West of the Sixth Principal Meridian, County of Weld, State of Colorado.

I hereby state that this Well Location Certificate was prepared by me, or under my direct supervision, that the fieldwork was completed on 11/29/2012, for and on behalf of Noble Energy Inc. That this is not a Land Survey Plat or an Improvement Survey Plat, and that it is not to be relied upon for establishment of fence, building, or other future improvement lines.

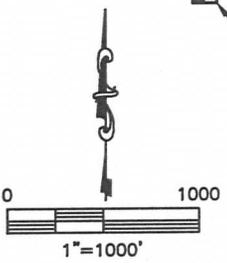


**SURFACE LOCATION**  
LAT: 40.76853N  
LONG: 103.86168W  
PDOP: 1.8  
ELEV: 4729'  
1/4,1/4: SE1/4NE1/4  
NEAREST PROPERTY LINE: 480' EAST

**BOTTOM HOLE**  
LAT: 40.76862N  
LONG: 103.87653W

- NOTE:
- 1) Bearings shown are Grid Bearings of the Colorado State Plane Coordinate System, North Zone, North American Datum 1983/2007. The lineal dimensions as contained herein are based upon the "U.S. Survey Foot."
  - 2) Ground elevations are based on an observed GPS elevation (NAVD 1988 DATUM).
  - 3) NEAREST EXISTING WELL: ROHN PC LD09-01, 1045'
  - 4) IMPROVEMENTS: See LOCATION DRAWING for all visible improvements within 400' of disturbed area.
  - 5) SURFACE USE: RANGELAND
  - 6) INSTRUMENT OPERATOR: BRIAN ROTTINGHAUS

**NOTE**  
According to Colorado law, you must commence any legal action based upon any defect in this W.L.C. within three years after you discover such defect. In no event, may any action based upon any defect in this survey be commenced more than ten years after the date of the certificate shown hereon. (13-80-105 C.R.S.)

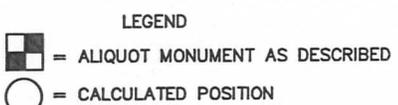


Brian T. Brinkman—On behalf of Lat40°, Inc.  
Colorado Licensed Professional Land Surveyor No. 38175  
DATE: 3/1/2013  
PROJECT#: 2012159

# SITE SKETCH

ROHN STATE LD09-67-1HN

SECTION: 9  
TOWNSHIP: 9N  
RANGE: 58W

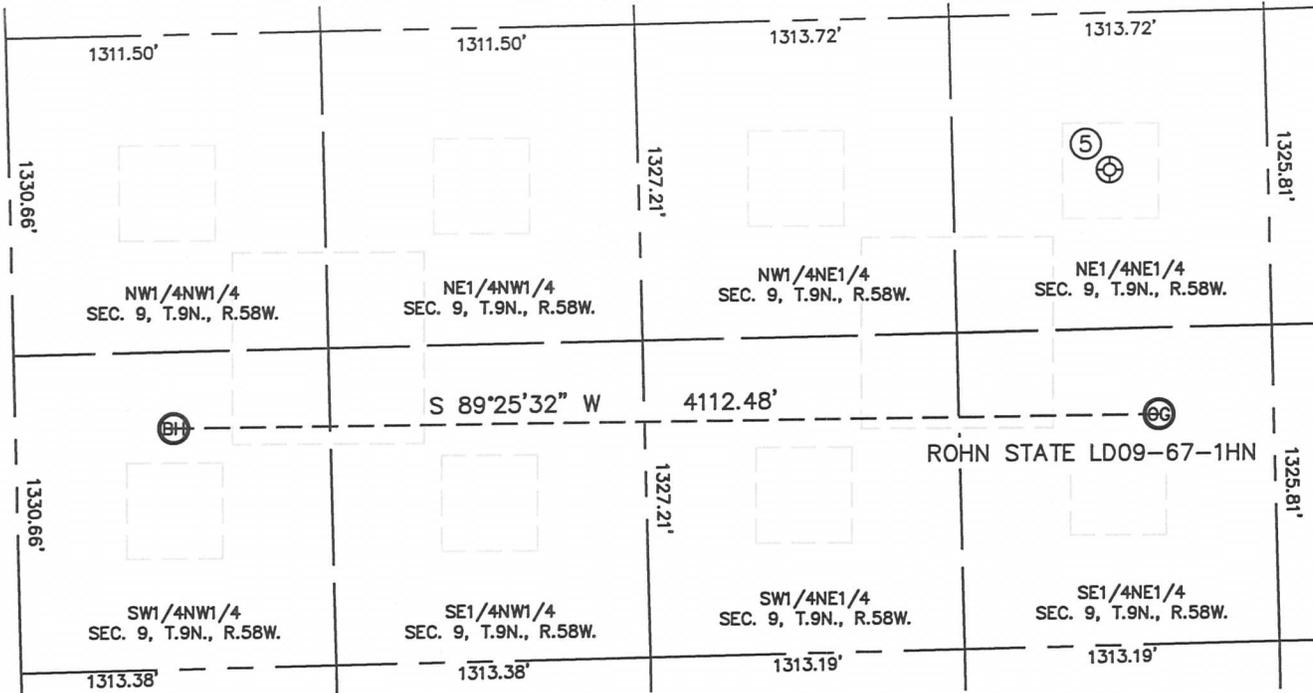

⑤  
ROHN PC LD09-01  
NE1/4NE1/4  
659' FNL  
660' FEL  
LAT-40.77135°N  
LONG-103.86236°W  
PDOP: 1.6  
ELEV: 4744'

