




Lat40°, Inc. 1635 Foxtrail Drive, Suite 325 Loveland, CO 970-776-3321

WELL LOCATION CERTIFICATE

SECTION: 32
TOWNSHIP: 6N
RANGE: 67W

THIS MAP DOES NOT REPRESENT A BOUNDARY SURVEY

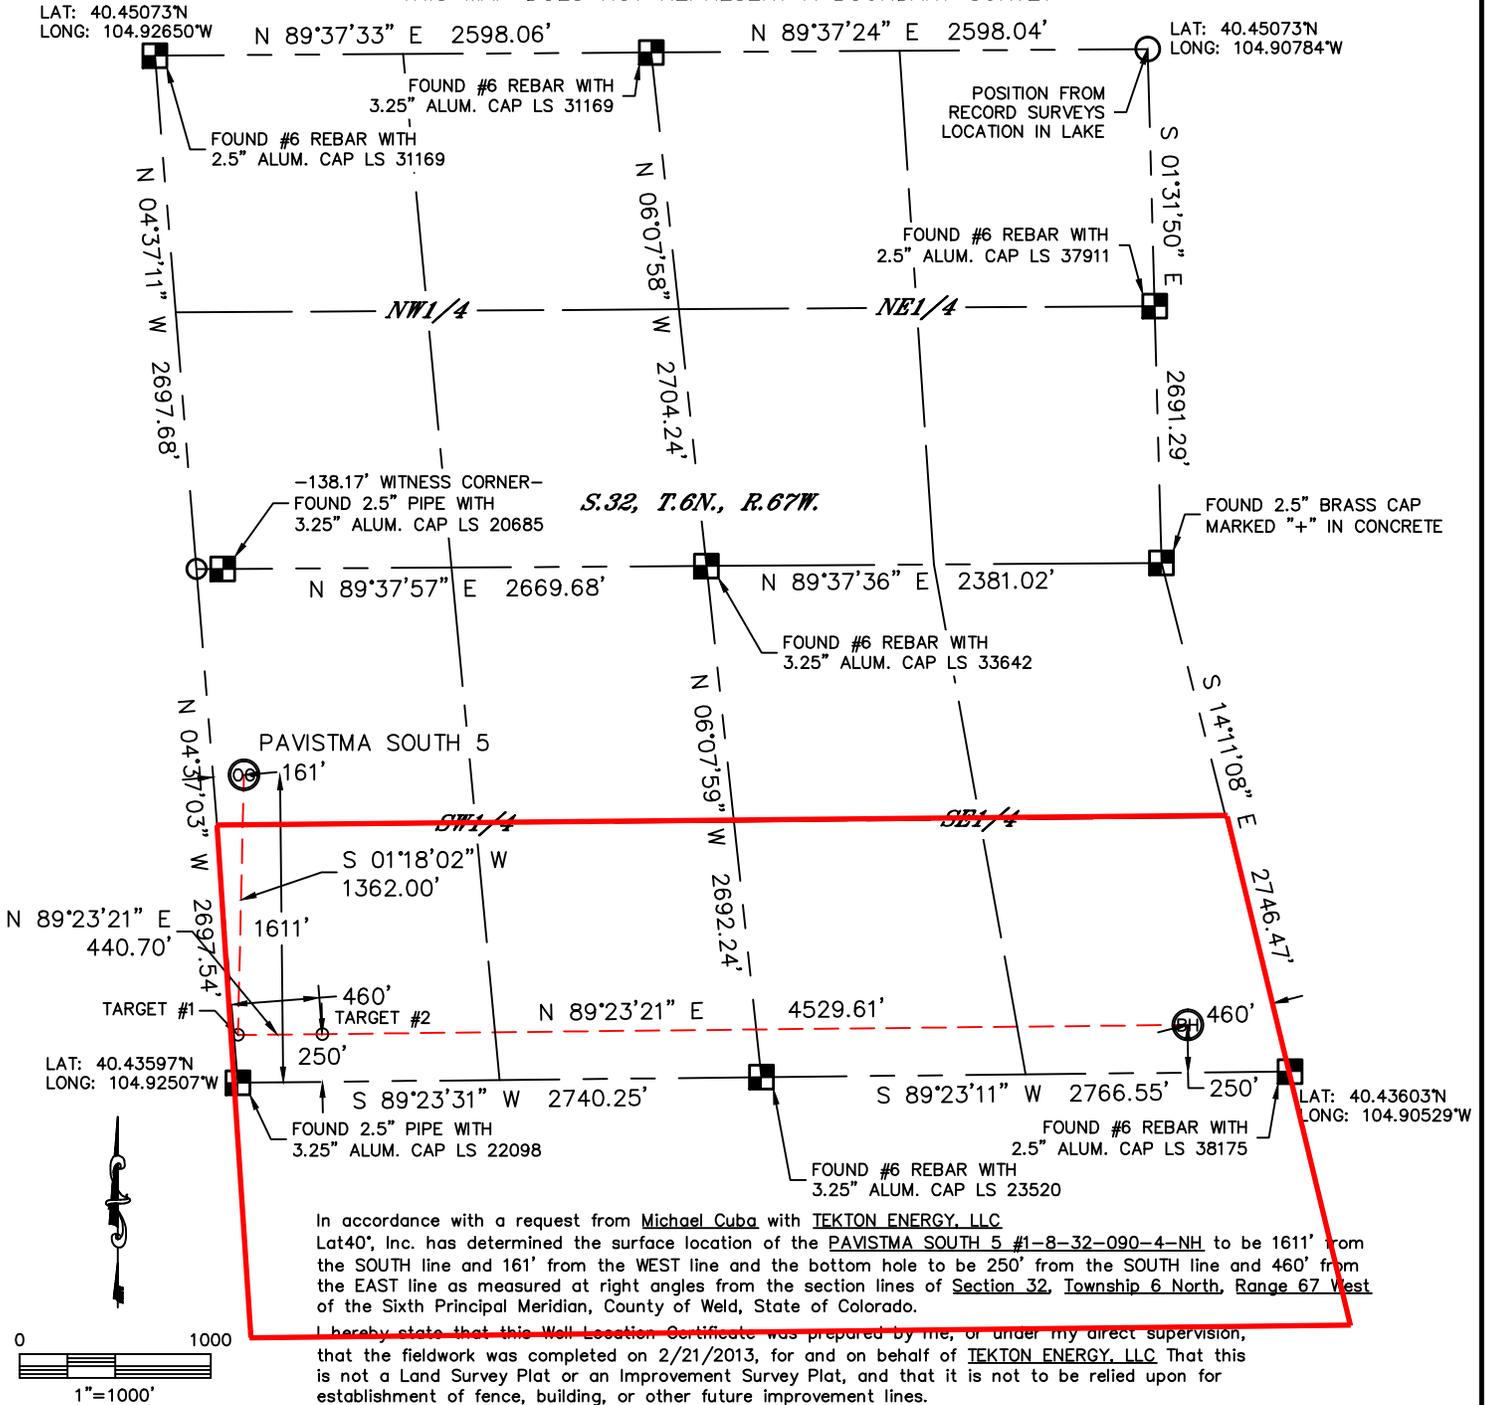

NOTE:

- 1) Bearings shown are Grid Bearings of the Colorado State Plane Coordinate System, North Zone, North American Datum 1983/2007. The lineal dimensions as contained herein are based upon the "U.S. Survey Foot."
- 2) Ground elevations are based on an observed GPS elevation (NAVD 1988 DATUM).
- 3) IMPROVEMENTS: See LOCATION DRAWING for all visible improvements within 400' of disturbed area.
- 4) SURFACE USE: EX. WELL PAD / CROPLAND
- 5) INSTRUMENT OPERATOR: WYATT HALL

SURFACE LOCATION

LAT: 40.44039°N
LONG: 104.92492°W
PDOP: 1.2
ELEV: 4954'
1/4,1/4: NW1/4SW1/4
NEAREST PROPERTY LINE: 161' WEST

BOTTOM HOLE

LAT: 40.43671°N
LONG: 104.90721°W

TARGET #1

LAT: 40.43666°N
LONG: 104.92506°W

TARGET #2

LAT: 40.43666°N
LONG: 104.92348°W


PROPOSED SPACING UNIT

NOTE

According to Colorado law, you must commence any legal action based upon any defect in this W.L.C. within three years after you discover such defect. In no event, may any action based upon any defect in this survey be commenced more than ten years after the date of the certificate shown hereon. (13-80-105 C.R.S.)

LEGEND

- = ALIQUOT MONUMENT AS DESCRIBED
- = CALCULATED POSITION

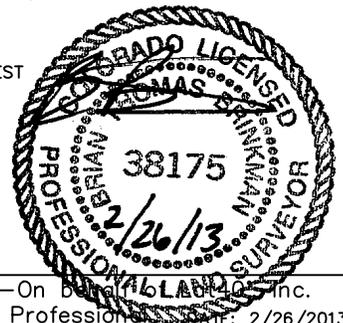

Brian T. Brinkman—On behalf of LAT40°, Inc.
Colorado Licensed Professional Surveyor
DATE: 2/26/2013
PROJECT#: 2011316