

Well Completion Diagram


API Well No: 05-075-09013-00-		Well Name: FLACK	
Owner: TIMKA RESOURCES LTD		Pool: LITTLE HOOT	
County: LOGAN	Field: 600 FWL	Sec: 13	Twp: 10N Rng: 54W
Coordinates: X			

Note: Changes to the drawing do not effect the database

Bore Diameters (in.)



Proposed Plugging Info

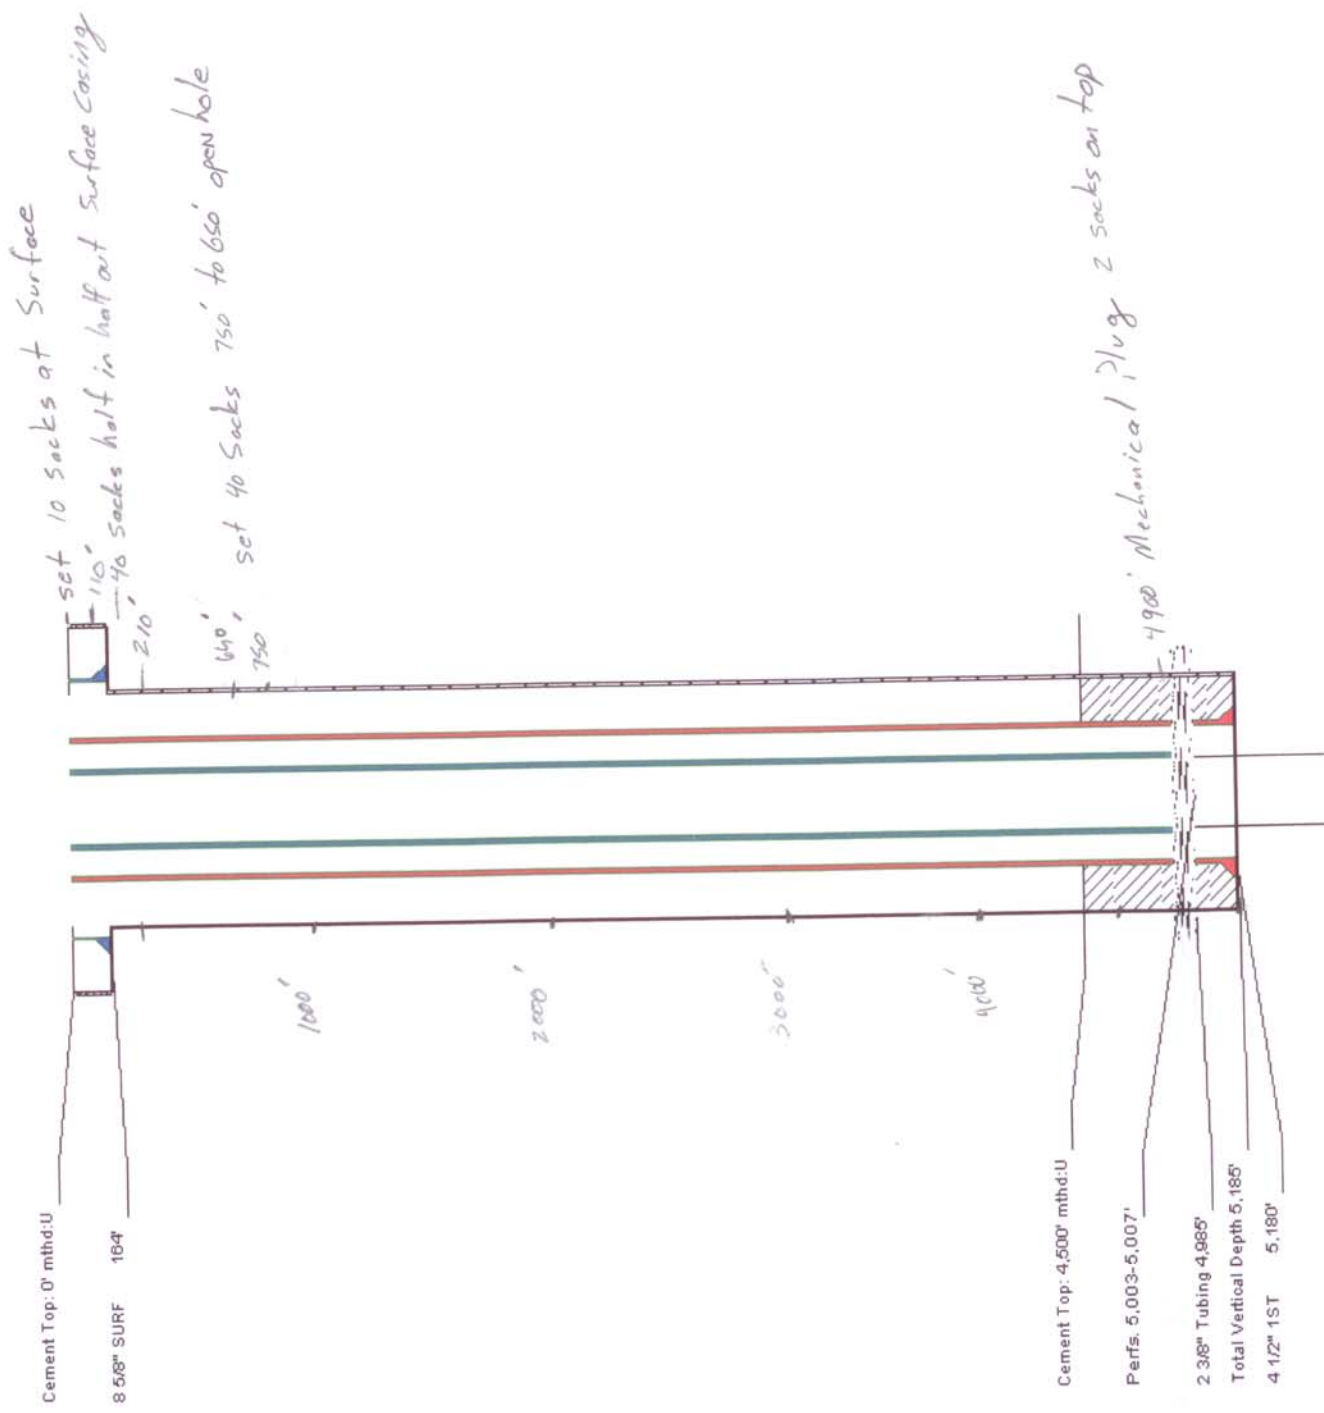

Well Completion Diagram

API Well No: 05-075-09013-00-		Well Name: FLACK	
Owner:	TIMKA RESOURCES LTD		
County:	LOGAN	Field:	LITTLE HOOT
Coordinates: X	600 FWL	Sec: 13	Twp: 10N Rng: 54W
		600 FNL	

Note: Changes to the drawing do not effect the database

Bore Diameters (in.)



Current state
 21 7/8" Rods
 179 3/4" Rods
 159 2 3/8" Tubing
 5TS

