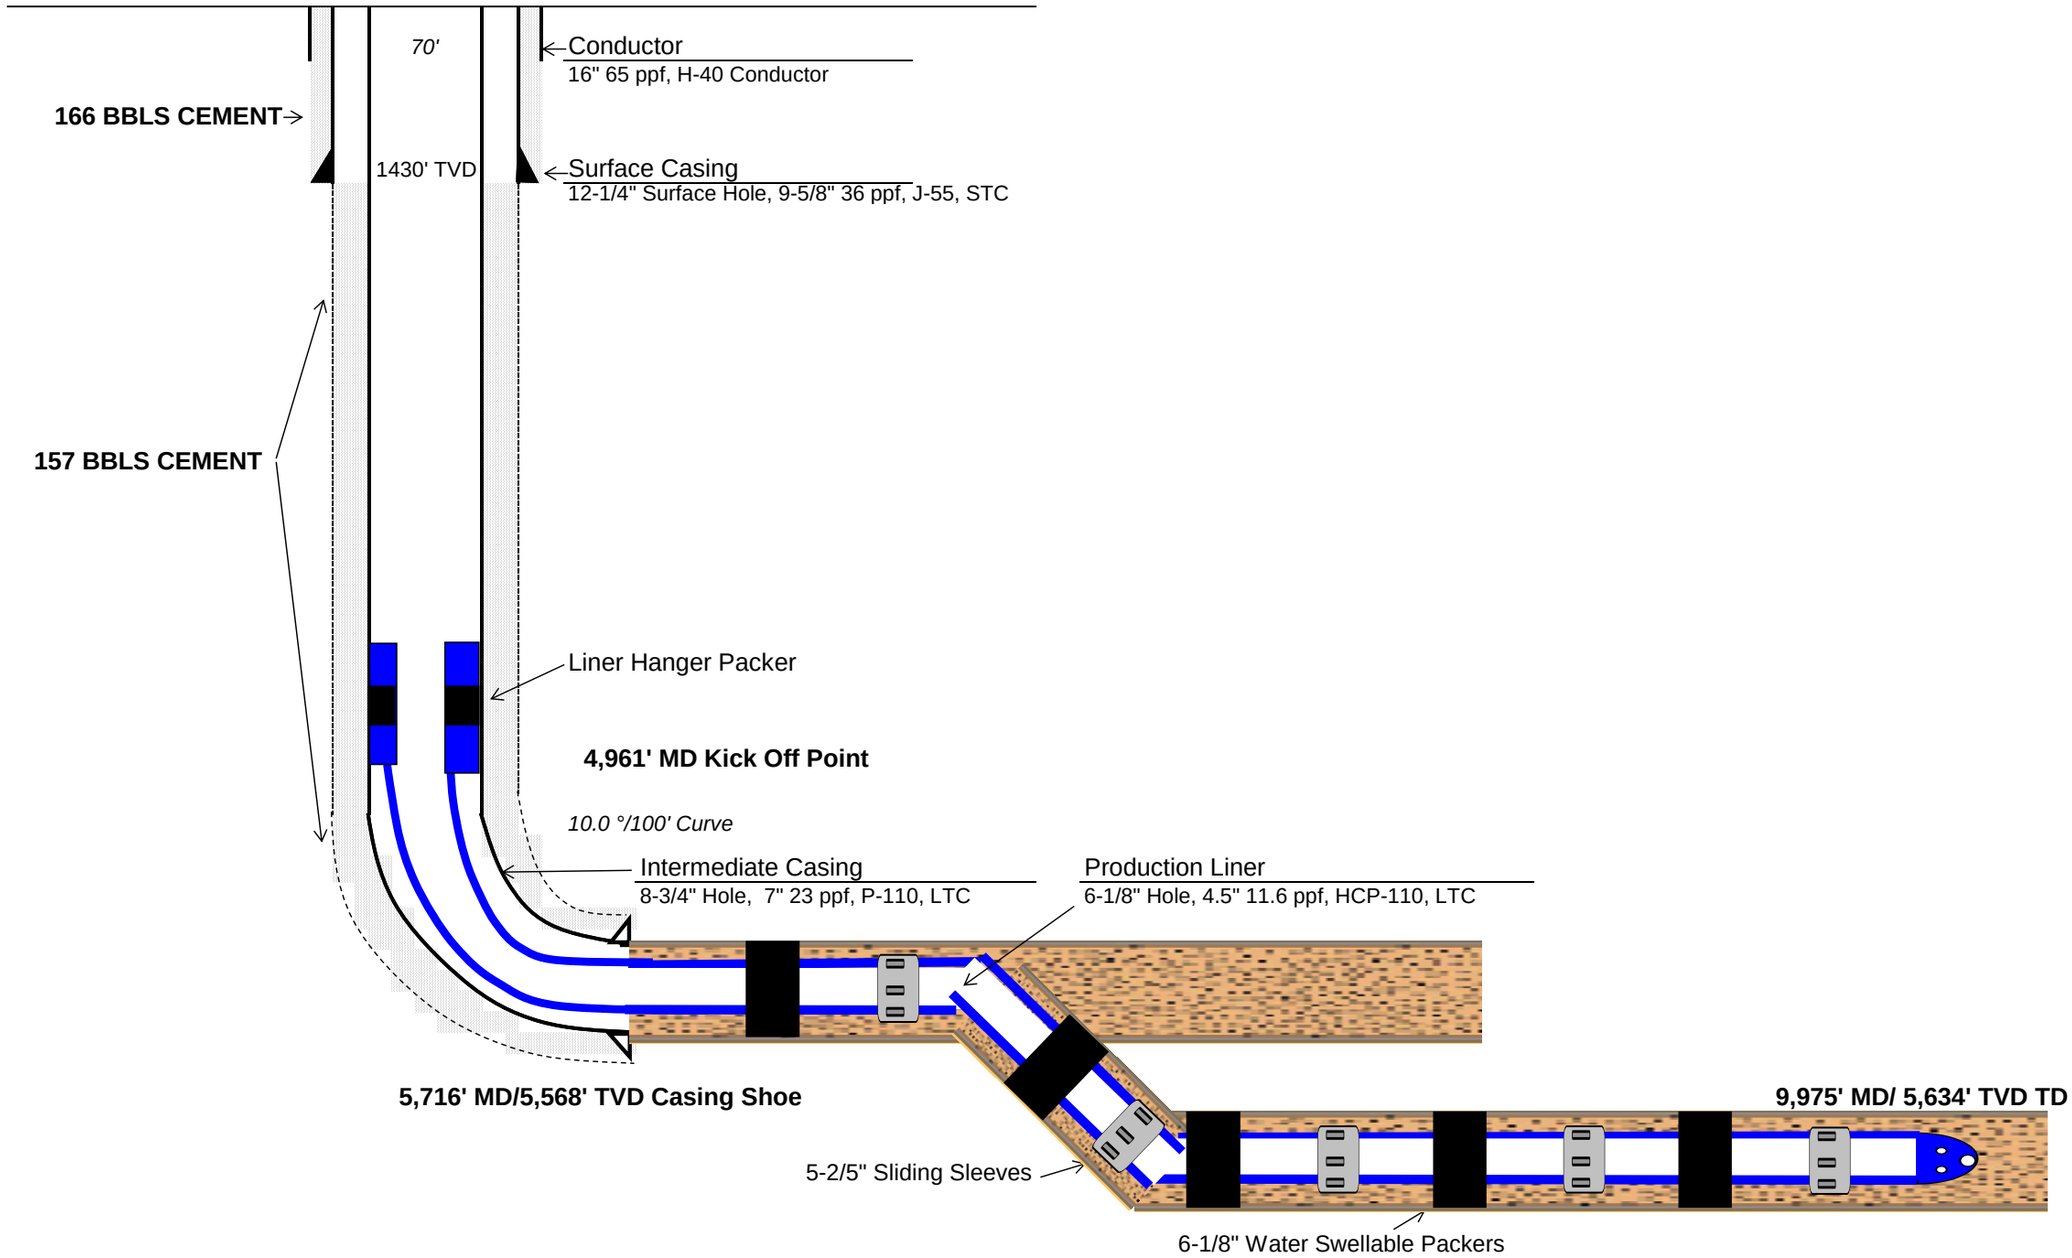BRINGELSON RANCH 1-34-41-9-58 ST DIAGRAM