




**Lease Name:** Swift #24-65

**Legals:** NWNE – Sec. 24, T6N, R66W

**County:** Weld County, Colorado

**API#:** 05-123-34088

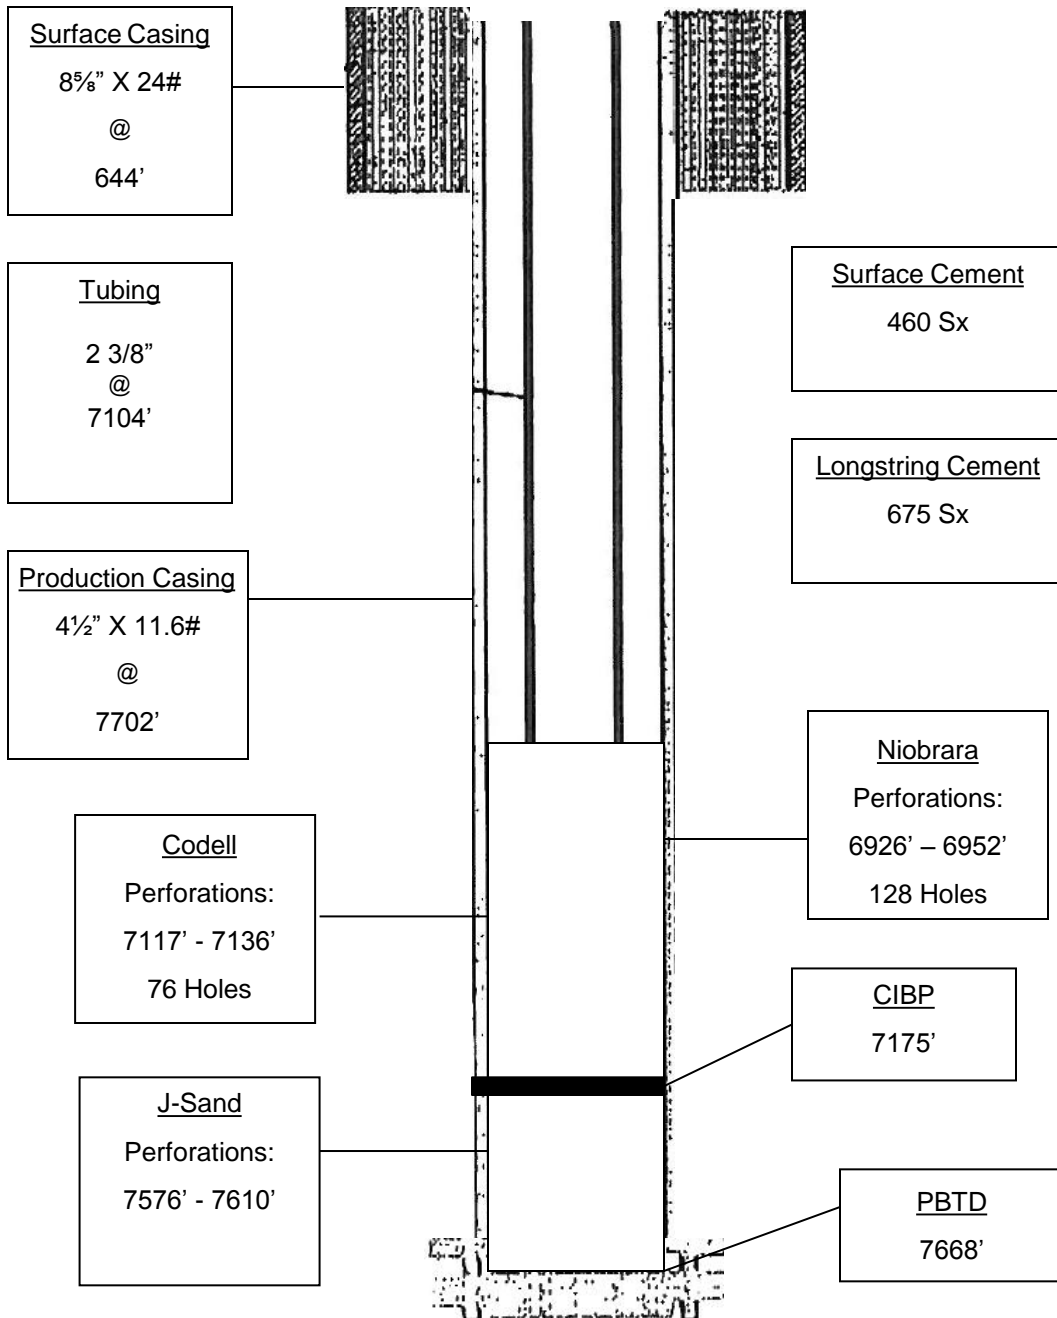

**Wellbore Diagram**