


WELL LOCATION CERTIFICATE: EISENACH FEDERAL 5N-8HZ

SECTION 8, TOWNSHIP 3 NORTH, RANGE 66 WEST, 6TH P.M.

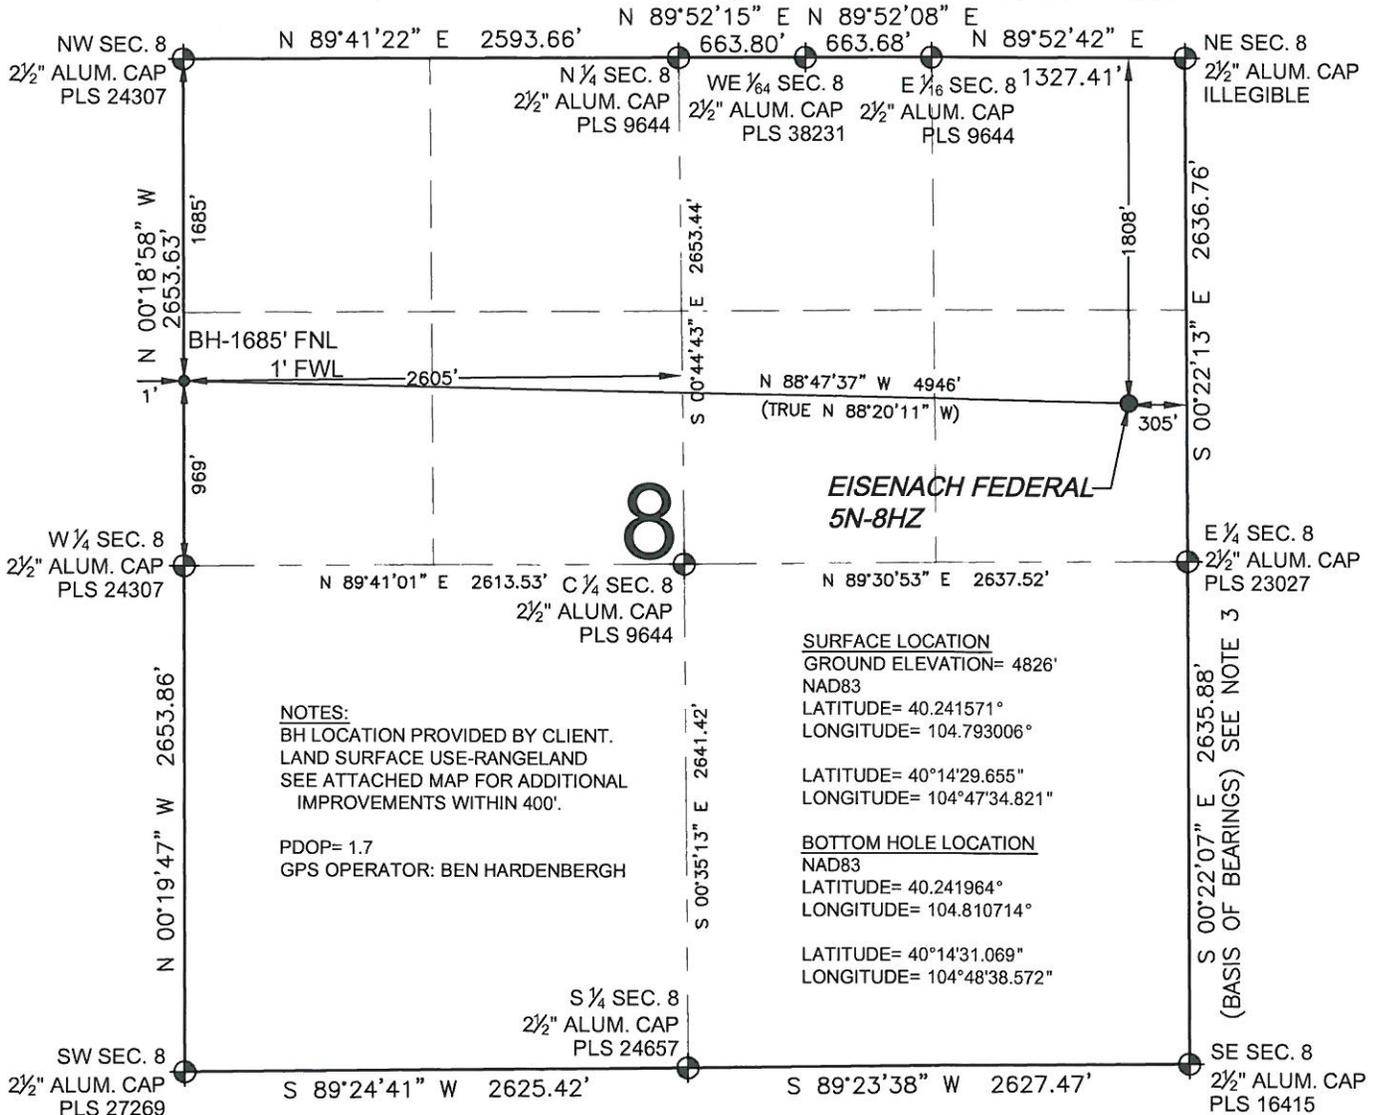

PREPARED BY: PFS Petroleum Field Services, LLC 1801 W. 13th Ave. Denver, CO 80204	FIELD DATE: 01-07-13	SURFACE LOCATION:
	DRAWING DATE: 04-25-13	SE 1/4 NE 1/4, SEC. 8, T3N, R66W, 6TH P.M.
BY: CLM	CHECKED: KAD	WELD COUNTY, COLORADO

