


Well Name: R. Godsey 14-35 2N46W

Location: Sec 35, 2N, 46W, Yuma Co. CO

## PLANNED

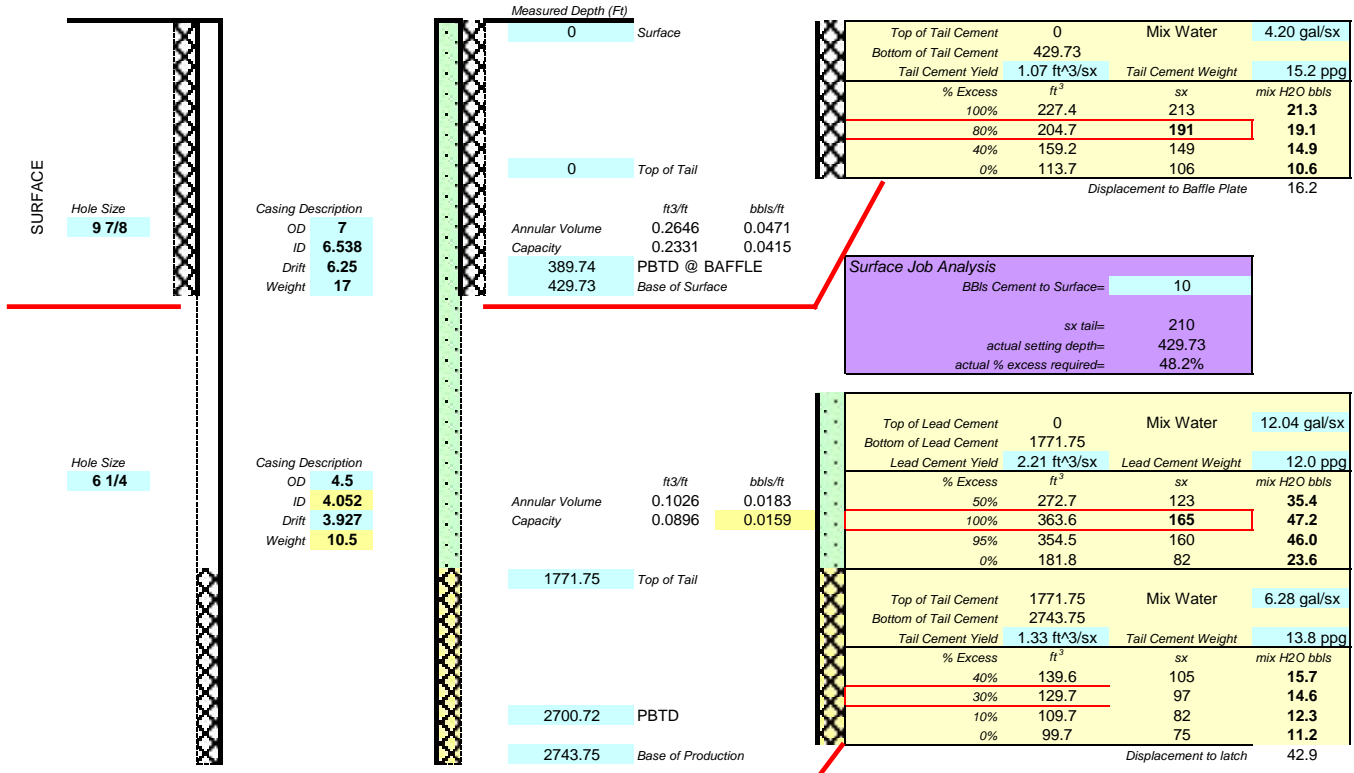

## AS PUMPED

<b>Surface</b>	<b>Date</b>	Saturday, April 20, 2013	44	= Capacity	Cu. Ft./ Ft.
<b>Job Description</b>	<b>DATE</b>	SURFACE	9.5	0.0162	0.0912
<b>Time</b>	<b>1815</b>		10.5	0.0159	0.0895
<b>Mud Flush</b>	<b>0</b>		11.6	0.0155	0.0872
<b>Lead Cement</b>	<b>190 sx 50/50 POZ, 3% CaCl, .25% flo-cel</b>		17	0.0415	0.2331
<b>Mix Water</b>	<b>4.20 gal/sx</b>		20	0.0405	0.2273
<b>Cement Yield</b>	<b>1.07 ft³/sx</b>		23	0.0393	0.2210
<b>Cement Weight</b>	<b>15.2 ppg</b>				
<b>Pump Rate</b>	<b>5.0 Bbls/min</b>				
<b>BBLs Displaced</b>	<b>16.0</b>				
<b>Bumped Plug</b>	<b>NA</b>				
<b>Floats Held</b>	<b>NA</b>				
<b>Full / Partial / No Returns</b>	<b>FULL</b>				
<b>Cement Circulated</b>	<b>yes</b>				
<b>Bbls Cement Circulated</b>	<b>10</b>				
<b>Pipe Reciprocated</b>	<b>NA</b>				
<b>Reciprocation length (ft)</b>	<b>NA</b>				
<b>Reciprocation Rate (SPM)</b>	<b>NA</b>				
<b>Time Job Complete</b>	<b>1830</b>				
<b>Production</b>	<b>Date</b>	Monday, April 22, 2013			
<b>Job Description</b>	<b>Longstring</b>				
<b>Time</b>	<b>1330</b>				
<b>Mud Flush w/ 2% KCl</b>	<b>10 KCl &amp; Dye, 43 KCL</b>				
<b>Lead Cement</b>	<b>160 sx 50/50 POZ, 12% GEL, 2% CACL</b>				
<b>Mix Water</b>	<b>12.04 gal/sx</b>				
<b>Cement Yield</b>	<b>2.21 ft³/sx</b>				
<b>Cement Weight</b>	<b>12.0 ppg</b>				
<b>Tail Cement</b>	<b>75 sx 50/50 POZ, 3% CaCl, .25% flo-cel</b>				
<b>Mix Water</b>	<b>6.28 gal/sx</b>				
<b>Cement Yield</b>	<b>1.33 ft³/sx</b>				
<b>Cement Weight</b>	<b>13.8 ppg</b>				
<b>BBLs Displaced 2% KCl water</b>	<b>42.9</b>				
<b>Pump Rate</b>	<b>3.0 Bbls/min</b>				
<b>Bumped Plug</b>	<b>Yes</b>				
<b>Floats Held</b>	<b>Yes</b>				
<b>Full / Partial / No Returns</b>	<b>Full</b>				
<b>Cement Circulated</b>	<b>Yes</b>				
<b>Bbls Cement Circulated</b>	<b>8</b>				
<b>Pipe Reciprocated</b>	<b>NO</b>				
<b>Reciprocation length (ft)</b>	<b>NA</b>				
<b>Reciprocation Rate (SPM)</b>	<b>NA</b>				
<b>Time Job Complete</b>	<b>1415</b>				