

Well Completion Diagram

API Well No: 05-123-08139-00-

Owner: TOP OPERATING COMPANY

Well Name: SCHNEIDER #1

County: WELD

Field: SPINDLE

Pool:

Coordinates: X 660 FEL


Y 660 FNL

Sec: 25 Twp: 2N

Rng: 67W

Note: Changes to the drawing do not effect the database

Bore Diameters (in.)

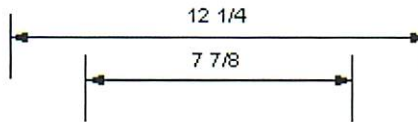

Cement Top: 0' mthd:U

Cement Top: 0' mthd:U

8 5/8" SURF 471'

10 SKS. CMT. IN SURFACE.

PERF. @ 700' SQZ. W/75SKS.

CIBP @ 4450' W/ 2 SKS CMT. ON TOP

Perfs. 4,530-4,567'

2" Tubing 4,601'

Total Vertical Depth 4,715'

WORK TO BE PERFORMED IN RED.

Schlumberger BlueView :
 00558882
 See Spaces for...
 reverse Side



X