

KERR-MCGEE OIL AND GAS ONSHORE LP

UPRR 22 PAN AM C 1

NE SW 27 3N 66W -- --

WELD,COLORADO

05/14/2013

AREA: S4

ROUTE: S44 Spud: 04/15/1971

WINS No.: 74893

AFE/WO#: 2082530

API#: 0512307302

GL: 4951

KB: 4963

MTD: 7976


TVD: 7976

LOG MD:

PBMD: 7943

PBTVD: 7943

Directions: WCR 28 & WCR 31, NORTH 2/10 MILE, EAST 2/10 MILE, NORTH INTO LOCATION.

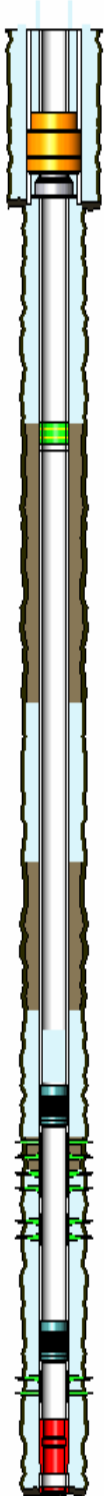

<u>HOLE SECTIONS</u>	<u>Size</u>	<u>Top</u>	<u>Btm</u>	<u>TD Date</u>
SURFACE	12.25	12	500	04/15/1971
PRODUCTION	7.88	500	7976	04/22/1971

<u>TUBULARS</u>	<u>Tool Type</u>	<u>Joints</u>	<u>Size</u>	<u>Weight</u>	<u>Grade</u>	<u>Thread</u>	<u>Top D</u>	<u>Bottom D</u>
SURFACE CASING	Casing	16	8.63	24	K-55	STC	12	499
PRODUCTION CASING	Casing	41	4.50	11.60	I-70	LTC	12	2191
	Cement Stage Too	1	4.50		K-55		2191	2192
	Casing	1	4.50	11.60	I-70	LTC	2192	2224
	Casing	204	4.50	10.50	K-55	LTC	2224	7944
	Casing Float Collar	1	4.50		K-55		7944	7945
	Casing	1	4.50	11.60	K-55	LTC	7945	7975
	Casing Guide Shoe	1	4.50				7975	7976
BRIDGE PLUG	Bridge Plug	1	4.50				7780	7793
BRIDGE PLUG	Bridge Plug	1	4.50				7130	7131
CAST IRON CEMENT RETAINER	Cement Stage Tool	1	8.63				450	451

<u>CEMENT JOBS</u>	<u>Stage</u>	<u>Sacks</u>	<u>Cement Jobs</u>	<u>Top D</u>	<u>Btm D</u>	<u>cbl</u>
SURFACE CASING	STAGE 1	500	G	10	499	No
PRODUCTION CASING	SQUEEZE 1	140	G	6558	7200	Yes
	STAGE 1	200	50/50 POZ-MIX	7240	7976	Yes
PRODUCTION CASING	REMEDIAL CEMENT	350	LEAD 50/50 POZ-MIX	12	2191	No
PRODUCTION CASING	ABANDONMENT PLUG	30	LEAD 50/50 POZ-MIX	6695	7115	No
PRODUCTION CASING	SQUEEZE JOB	600	LEAD 50/50 POZ-MIX	4170	5400	No
PRODUCTION CASING	SQUEEZE JOB	25	LEAD TYPE 3	540	560	No
PRODUCTION CASING	SQUEEZE JOB	100	LEAD TYPE 3	0	560	No

<u>PERFORATIONS</u>	<u>Formation</u>	<u>Zone</u>	<u>Top</u>	<u>Btm</u>	<u>Date</u>	<u>Reason</u>	<u>Comments</u>
			560	561	03/12/2013	CEMENT SQUEEZE	
			4185	4186	03/13/2013	CEMENT SQUEEZE	
			5400	5401	03/13/2013	CEMENT SQUEEZE	
	NIOBRARA		7198	7224	12/11/1996	PRODUCTION	
	NIOBRARA		7200	7201	12/09/1996	CEMENT SQUEEZE	
	NIOBRARA		7238	7260	12/11/1996	PRODUCTION	
	CODELL		7395	7410	12/11/1996	PRODUCTION	
	CODELL		7396	7406	06/10/2002		
	J SAND		7842	7886	04/15/1971	PRODUCTION	

Comments: