


**KERR-MCGEE OIL AND GAS ONSHORE LP**  
**TUTTLE J BURTON GU 1**  
**SE SW 8 3N 66W 300' FSL 2,395' FWL**  
**WELD,COLORADO**  
**05/20/2013**

AREA: N3      ROUTE: N33    Spud: 07/31/1975      WINS No.: 75790      AFE/WO#: 2082224      API#: 0512308424

GL: 4862    KB: 4872    MTD: 7990    TVD: 7990    LOG MD: 7958    PBMD: 7932    PBTVD: 7932

Directions:    HWY 85 & WCR 34, E 1/2, N INTO

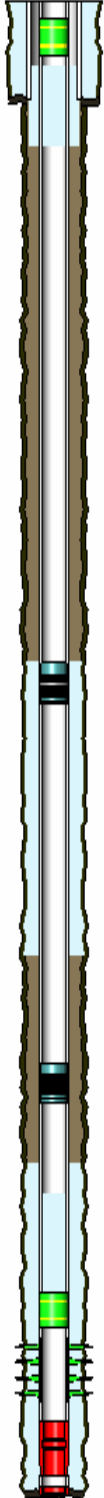

HOLE SECTIONS	Size	Top	Btm	TD Date
SURFACE	12.25	10	409	07/31/1975
PRODUCTION	7.88	409	7990	08/18/1975

TUBULARS	Tool Type	Joints	Size	Weight	Grade	Thread	Top D	Bottom D
SURFACE CASING	Casing	10	8.63	24.00	K-55	STC	10	404
PRODUCTION CASING	Casing	193	4.50	10.50	K-55	LT&C	10	7943
	Float Collar	1	4.50				7943	7945
	Casing	1	4.50	10.50	K-55	LT&C	7945	7987
	Casing Guide Shoe	1	4.50				7987	7988
BRIDGE PLUG	Cast Iron Bridge Plu	1	4.50				7760	7762
BRIDGE PLUG	Bridge Plug	1	4.50				4130	4132
CICR	Bridge Plug	1	4.50				6510	6512
BRIDGE PLUG	Cast Iron Bridge Plu	1	4.50				100	102

CEMENT JOBS	Stage	Sacks	Cement Jobs	Top D	Btm D	cbl
SURFACE CASING	STAGE 1	325	G	10	404	No
	ONE INCH JOB	150	G	10	103	No
PRODUCTION CASING	STAGE 1	200	50/50 POZMIX	6900	7988	No
PRODUCTION CASING	ABANDONMENT PLUC	40	LEAD FRESH WATER	7100	7750	No
PRODUCTION CASING	SQUEEZE JOB	1000	LEAD FRESH WATER	4120	5800	No
SURFACE CASING	ABANDONMENT PLUC	175	LEAD FRESH WATER	180	710	No

PERFORATIONS	Formation	Zone	Top	Btm	Date	Reason	Comments
			4120	4121	04/19/2013	CEMENT SQUEEZE	
			5800	5801	04/19/2013	CEMENT SQUEEZE	
			6500	6501	04/19/2013	CEMENT SQUEEZE	
			7000	7001	04/19/2013	CEMENT SQUEEZE	
	J SAND		7822	7830	09/10/1975	PRODUCTION	
	J SAND		7840	7890	09/10/1975	PRODUCTION	

Comments: