

Well Completion Diagram

API Well No: 05-123-09795-00-

Owner: UNKNOWN

Well Name: VALARIE G. HITCHINGS

County: WELD

Field: SPINDLE

Pool:

Coordinates: X 660 FEL

Y 660 FSL


Sec: 25

Twp: 2N

Rng: 67W

Note: Changes to the drawing do not effect the database

Bore Diameters (in.)

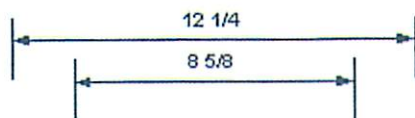

Cement Top: 0' mthd:U

Cement Top: 0' mthd:U

* 8 5/8" SURF 78'

Perf. @ 700' L

Sg2 w/ 75 SKS Carb

P&A changes highlighted and
underlined in red

* Drilling contract called for setting 500' of surface pipe. Contractor set 78'. Therefore, Otis Sliding Sleeve was set to 640 feet K.B., set 16 joints below bottom of surface pipe. Spotted 1000 gallons E.T.S. cement. gel through Otis Sleeve and circulated to surface.

Perfs 4548-4604

4 1/2" - 10.5 @ 4718 w/ 200 SKS

DETH. 7,040-11,000+

2 3/8" Tubing 4,646'

Total Vertical Depth 4,720'

CIBPW 2.5 Kg of Cement on Top
@ 4530'