


Well **BEARDEN 2-8-6**
Operator EnCana Oil & Gas (USA) Inc.
Location NESW Section 6-T1N-R68W
County WELD
State Colorado
Field Wattenberg
Footages 1371' FSL; 1542' FWL

Spud Date: 02-08-13
TD Date: 02-14-13

Log Tops

Sussex	4540'
Niobrara	7549'
Codell	7903'
J Sand	8330'

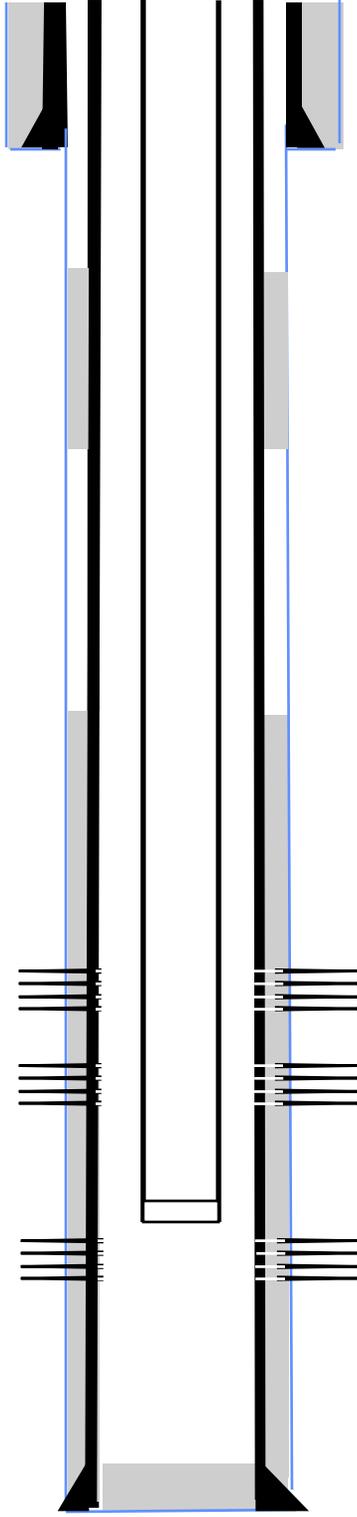

Surface Casing and Cement

8 5/8" , landed @ 755', cemented with 350 sxs

Main Hole

7-7/8" to TD

Production Casing and Cement

4-1/2" , landed @ 8449', cemented with 695 sxs

CBP

Set @ 7575'. 04-27-13
 Drilled out on 04-29-13

Perf'd the Niobrara from 7665' – 7679' @ 4 spf
 Frac'd the Niobrara with 109,880# 40/70 with 116,172 gals SLF.
 04-19-13

CFP

Set @ 7730'. 04-19-13
 Drilled out on 04-29-13

Perf'd the Codell from 7904-7921' @ 3 spf
 Frac'd the Codell with 109,420# 40/70 with 112,098 gals SLF.
 04-19-13

CFP

Set @ 7971'. 04-19-13
 Drilled out on 04-29-13

Production Tubing

2-3/8" tubing, set @ 8306'

Perf'd the J Sand 8333-8339', 8345-8,361' @ 3 spf
 Pumped the J Sand from 0.25# to 2.0# slickwater with 109,500#
 40/70 sand and 104,496 gals SLF. 04-18-13

8460' — Driller's TD