



Well Name: PA 433-33

Surface Location: PA 333-33 Pad

NAD 1927 (NADCON CONUS) , US State Plane 1927 (Exact solution) , Colorado Central 502

Ground Elevation: 5164.0

+N/-S

+E/-W

Northing

Easting

Latitude

Longitude

Slot

0.0



0.0

608888.20

1294128.70

39°28'42.709N

108°0'3.391W

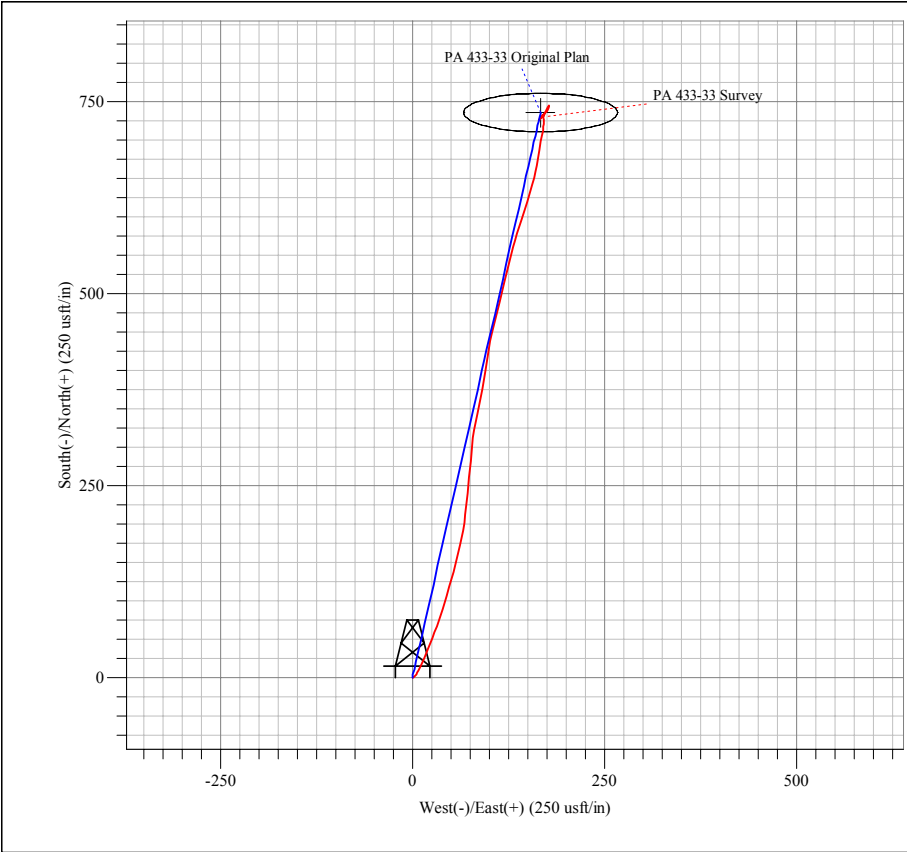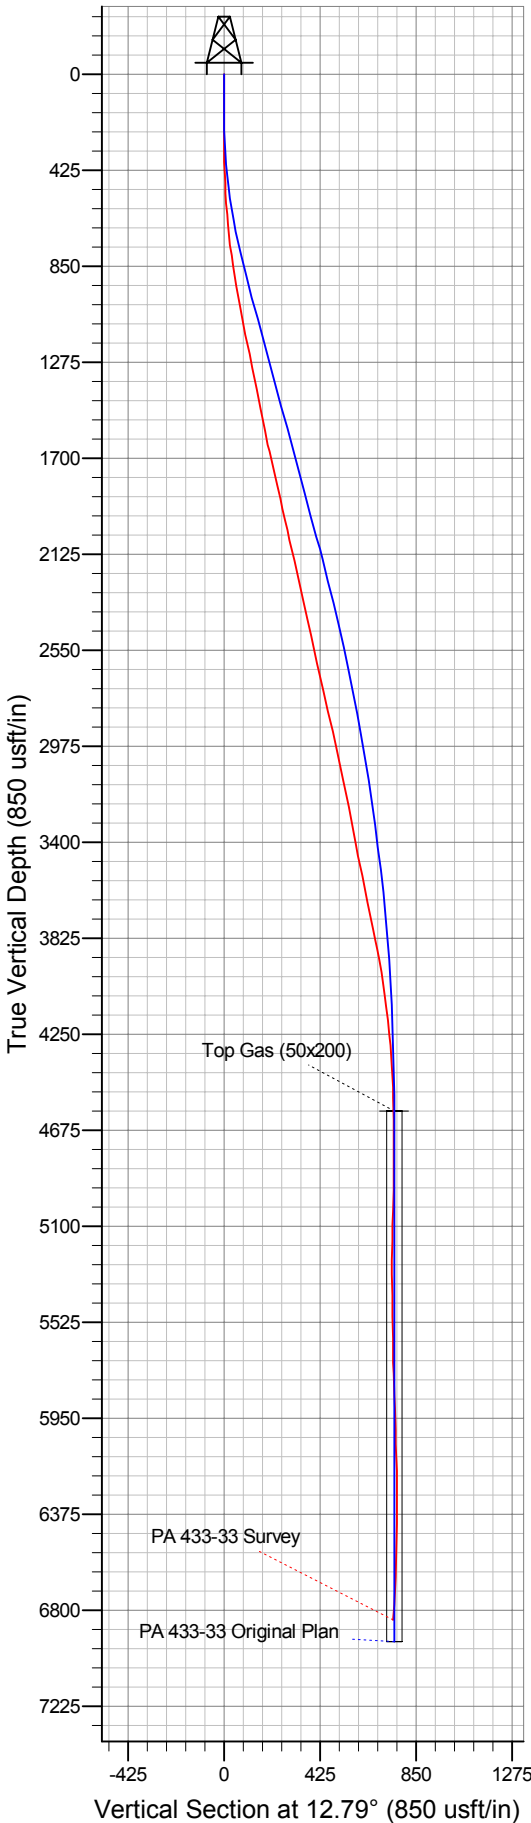

M Azimuths to True North
Magnetic North: 11.50°

Magnetic Field
Strength: 53092.6nT
Dip Angle: 65.98°
Date: 5/24/2004
Model: IGRF2000

SECTION DETAILS										
Sec	MD	Inc	Azi	TVD	+N/-S	+E/-W	DLeg	TFace	VSec	Target
1	0.0	0.00	12.79	0.0	0.0	0.0	0.00	0.00	0.0	
2	150.0	0.00	12.79	150.0	0.0	0.0	0.00	12.79	0.0	
3	905.1	15.10	12.79	896.4	96.5	21.9	2.00	12.79	99.0	
4	2153.8	15.10	12.79	2101.9	413.7	94.0	0.00	0.00	424.3	
5	4670.9	0.00	12.79	4590.0	735.4	167.0	0.60	180.00	754.1	Top Gas (50x200) PA 433-33
6	7020.9	0.00	12.79	6940.0	735.4	167.0	0.00	12.79	754.1	