

KERR-MCGEE OIL AND GAS ONSHORE LP

EICHTHALER MARG B 2

C- NW 35 2N 65W -- --

WELD,COLORADO

05/30/2013

AREA: S5

ROUTE: S51

Spud: 09/12/1979

WINS No.: 75345

AFE/WO#: 88335293

API#: 0512309778

GL: 4928

KB: 4938

MTD: 7988


TVD: 7988

LOG MD: 7988

PBMD: 7988

PBTVD: 7988

Directions: WCR 47 & WCR 16, W 7/10, S 2/10 INTO

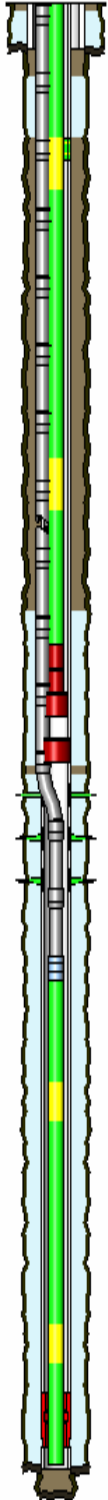

HOLE SECTIONS	Size	Top	Btm	TD Date
SURFACE	12.25	10	281	09/12/1979
PRODUCTION	7.88	281	7841	09/13/1979
DEEPEMED	3.88	7841	7988	04/16/1997
PRODUCTION	3.88	7841	7988	04/11/1997

TUBULARS	Tool Type	Joints	Size	Weight	Grade	Thread	Top D	Bottom D
SURFACE CASING	Casing	7	8.63	24			10	281
PRODUCTION CASING	Casing	20	4.50	11.60	K-55	LTC	10	810
	Cement Stage Too	1	4.50				810	815
	Casing	175	4.50	11.60	K-55	LTC	815	7791
	Float Collar	1	4.50				7791	7793
	Casing	1	4.50	11.60	K-55	LTC	7793	7835
PRODUCTION TUBING	Tubing	243	2.38	4.70	J-55	8RD EUE	10	7816
	Seating Nipple	1	2.38				7816	7817
	Notched Collar	1	2.38				7817	7818
Cement Retainer	Wellbore Equipment	1	4.50				6910	6912
Kill String		205	2.38	4.70	J-55	8RD EUE	10	6489
	Wellbore Equipment	1	2.38				6489	6490
	Wellbore Equipment	1	2.38				6490	6491
	Wellbore Equipment	1	3.80				6491	6492

CEMENT JOBS	Stage	Sacks	Cement Jobs	Top D	Btm D	cbl
SURFACE CASING	STAGE 1	300	UNKNOWN	50	281	No
PRODUCTION CASING	PRIM CMT 1ST STAGE	200	LEAD PRIMARY	7070	7835	No
	PRIM CMT 2ND STAGI	200	LEAD ACROSS FH	437	810	No
PRODUCTION CASING	SQUEEZE JOB	220	LEAD FRESH WATER	6910	6959	No

PERFORATIONS	Formation	Zone	Top	Btm	Date	Reason	Comments
			6950	6951	04/22/2013	CEMENT SQUEEZE	
	CODELL		7223	7238	06/15/1985	PRODUCTION	
	J SAND		7662	7682	01/14/1980	PRODUCTION	
	J SAND		7688	7704	01/14/1980	PRODUCTION	
	DAKOTA		7835	7988	04/11/1997	OPEN HOLE DEEPENING	

Comments: