



Physical Address: 345 Comanche St.
Mail to: Box 384, Kiowa, CO 80117
Ph. 303-621-8672 - Fax 303-621-7749
www.highprairiesurvey.com

Job # 13103 Moyer #1

Inv # 2421

High Prairie Surveying of Kiowa, Colorado, in accordance with a request from **Pronghorn Operating LLC**, has determined the location of **Moyer #1** to be **620 feet FNL**, and **620 feet FWL**, (90° off Section lines) of **SECTION 36**, Township **13s**, Range **44w** of the 6th Principal Meridian, **Cheyenne County**, Colorado.

Date: Staked on 5/23/13 drawn on 5/30/13.

Re:

Drawn:

Staked by Elijah Frane


Drawn by Dustin Coffey

Location Drawing



There is a capped well
42' Southeast of proposed
well head.

4169

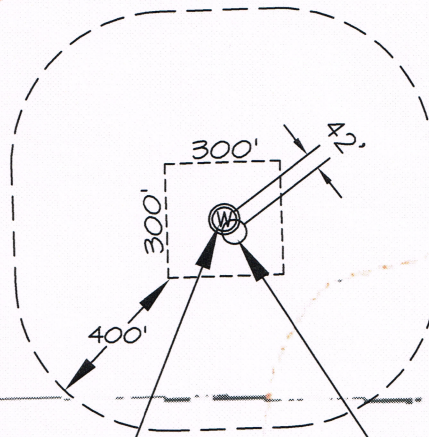

Pronghorn Operating LLC
NW 1/4 Sec. 36-13s-44w
Moyer #1
Cheyenne County, Colorado

State-Moyer #1
(Capped Well)