

WELLBORE DIAGRAM


Directions: Hwy 85 N to Hwy 392, W to WCR 21, N to WCR 78, 1/2 mi W, N to loc

Bayswater Exploration & Prod Ranchero 13-22

SESW Sec 22 T7N R67W
SHL: 225' FSL, 2394' FWL
BHL: 684' FSL, 650' FWL
Weld County CO
05-123-35688

Updated
02/25/13
JRR

G.L.= 5004
K.B.= 5020
16

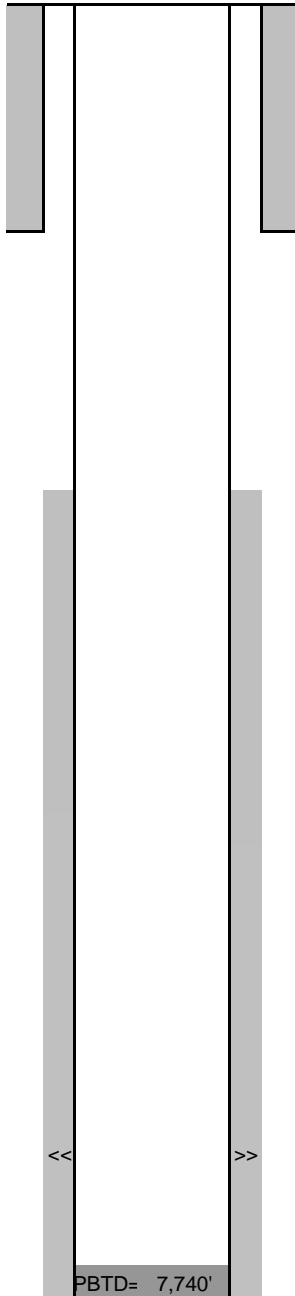

8-5/8" 24# set at 768' (12-1/4" hole)
Cmt'd w/ 540 sx to Surf.

TOC: 1346'
CBL

CODL: 7575'-7594', 4 spf
8/17/12 SW Frac: 278,254 gals, 181,185 gals SLF, 179,920 lbs 30/50 White

4-1/2" 11.6# CSG @ 7756' (7-7/8" O.H.)
Cmt'd w/ 1030 sx

PBD= 7,740'
TD MD= 7,766'
TD VD= 7,465'