


Lat40°, Inc. 1635 Foxtrail Drive, Suite 325 Loveland, CO 970-776-3321

# ACCESS ROAD MAP

## WELLS RANCH AA27-79HN PAD

SECTION: 21  
TOWNSHIP: 6N  
RANGE: 63W

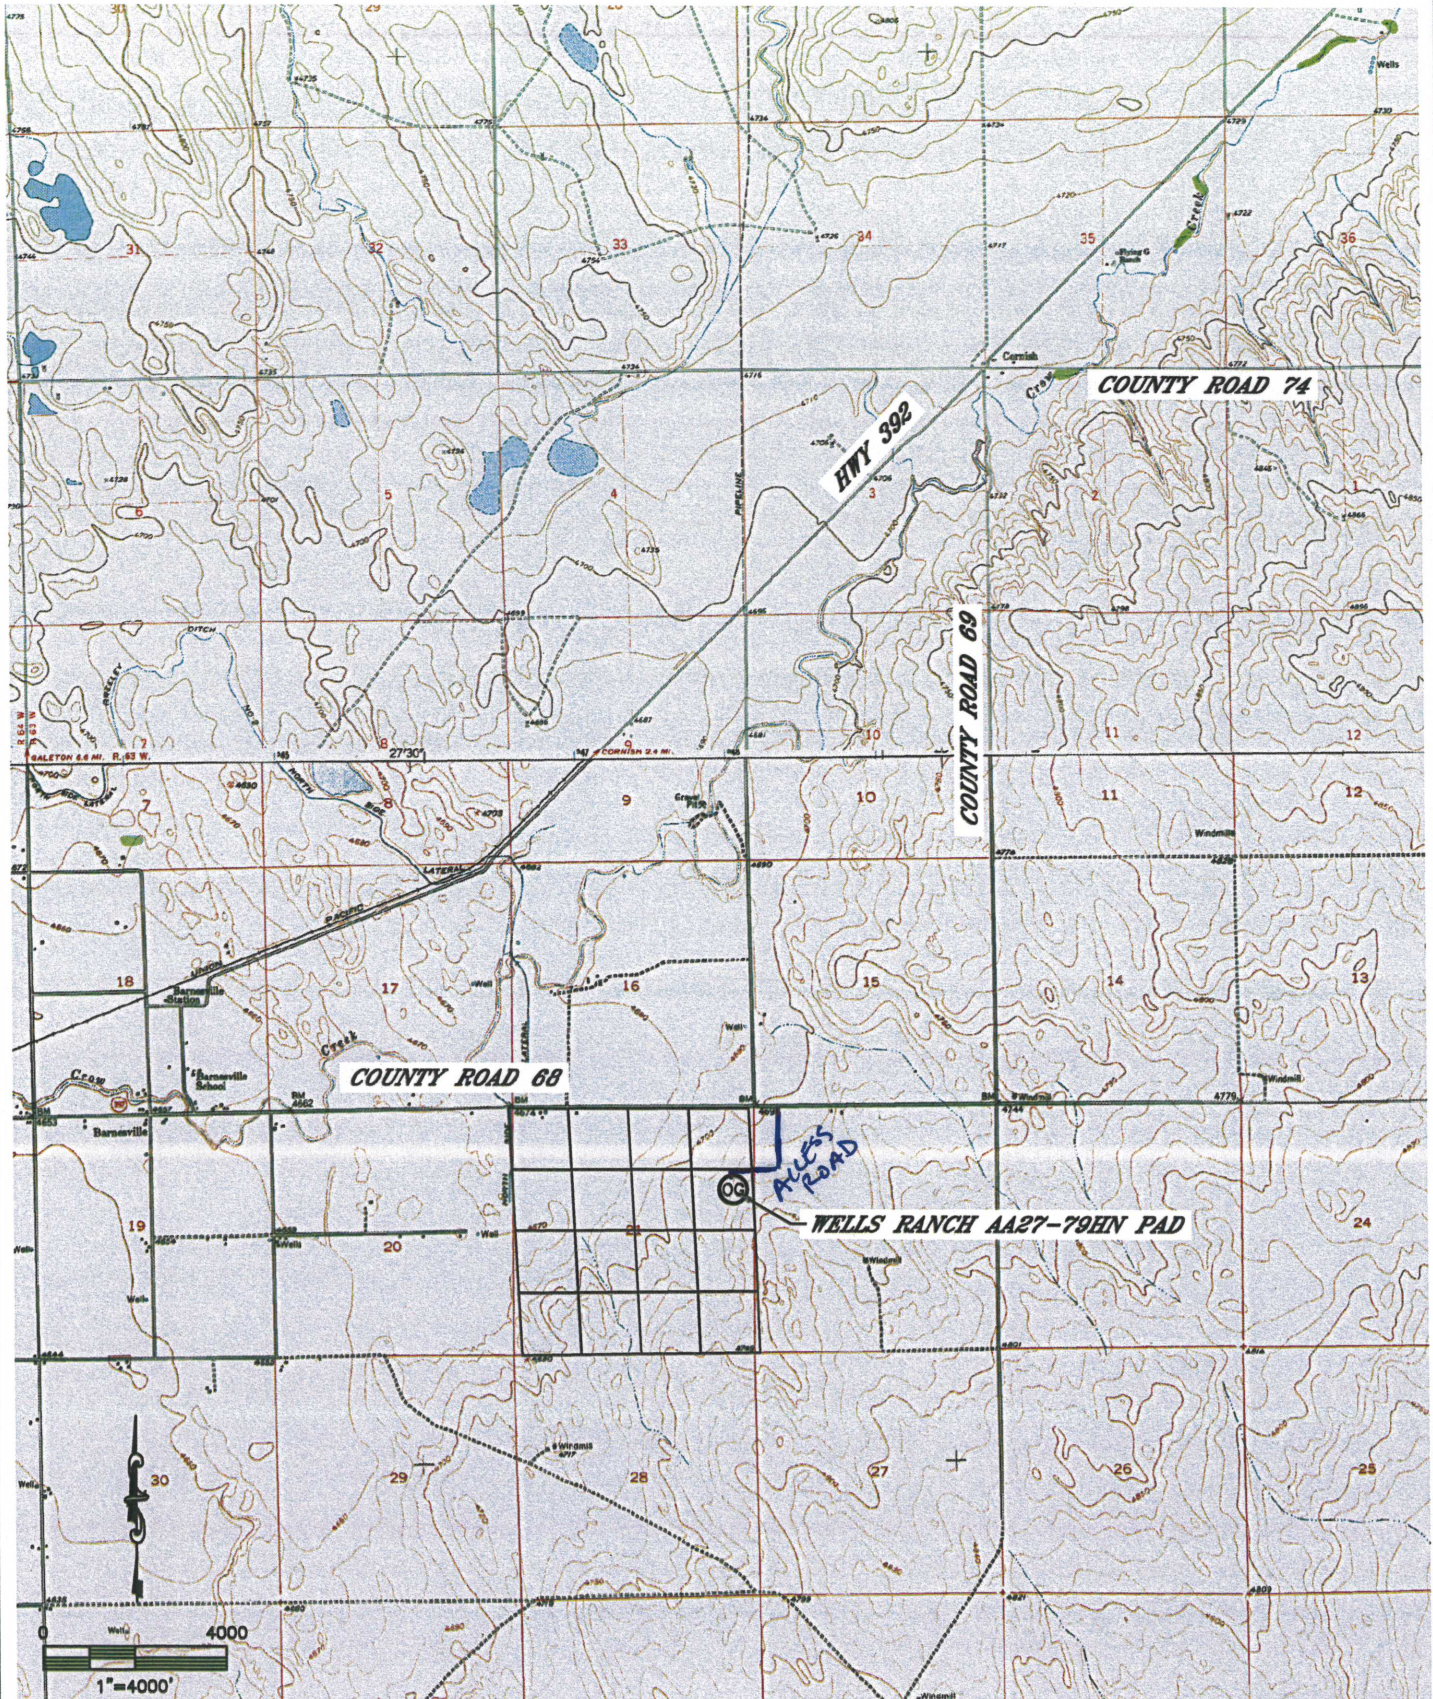

DATE: 11/16/2012  
PROJECT#: 2012141