


WPX Energy Rocky Mtn LLC
RWF 532-36
 API #05-045-21550-00
 2567' FNL x 2567' FEL - SHL
 2155' FNL x 2039' FEL - BHL
 (SWNE) Sec. 36-T6S-R94W
 Garfield County, Colorado

FINAL

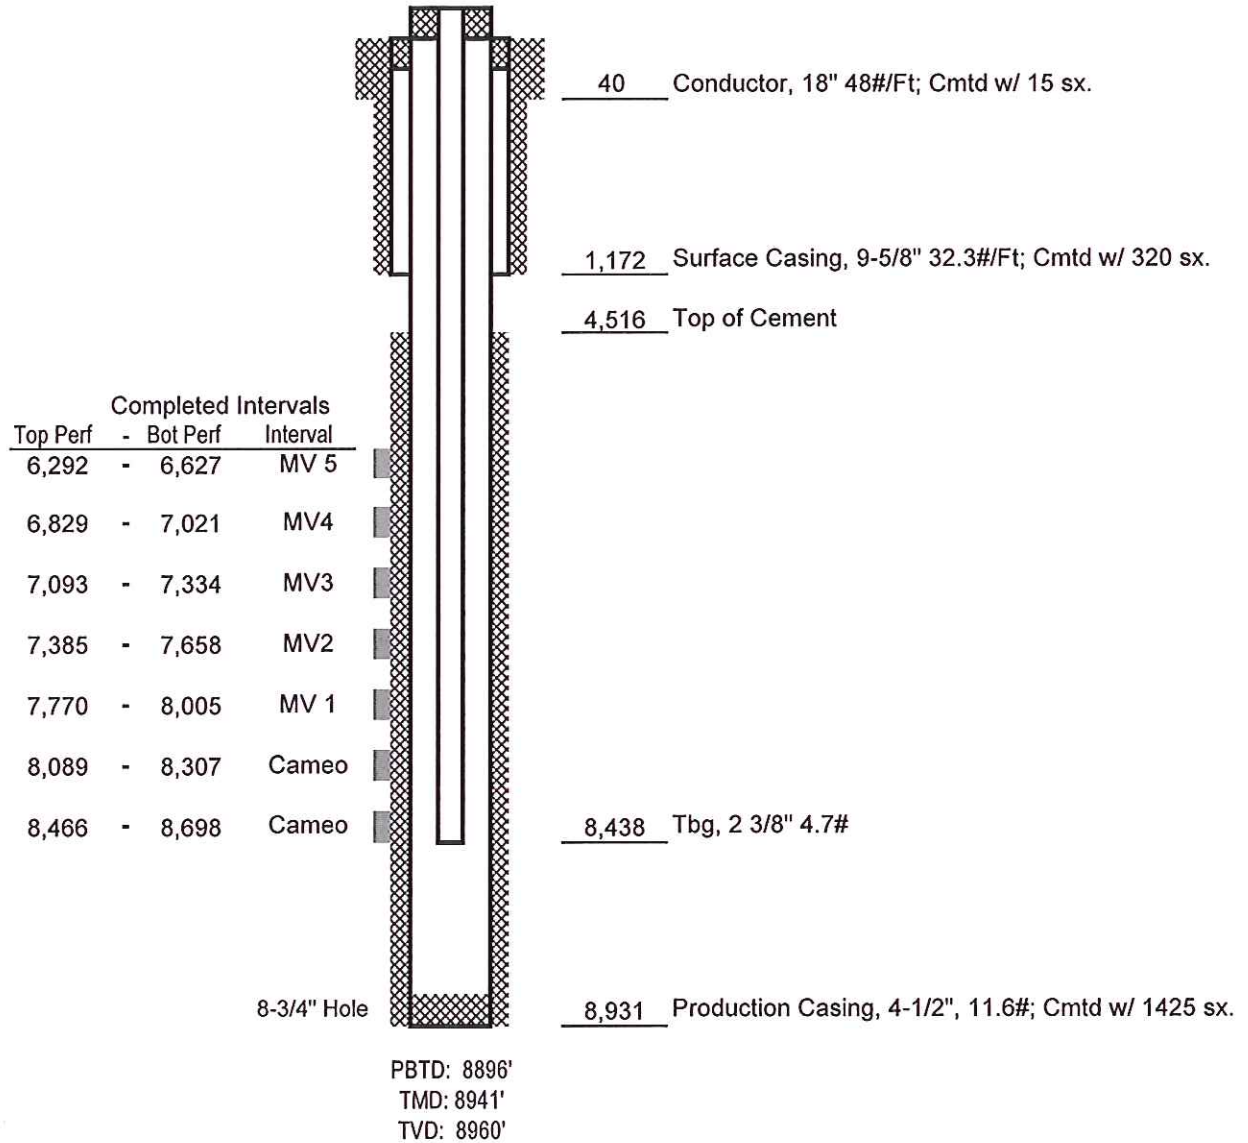

Not to Scale