


Section 26  
T. 1 S., R. 98 W.

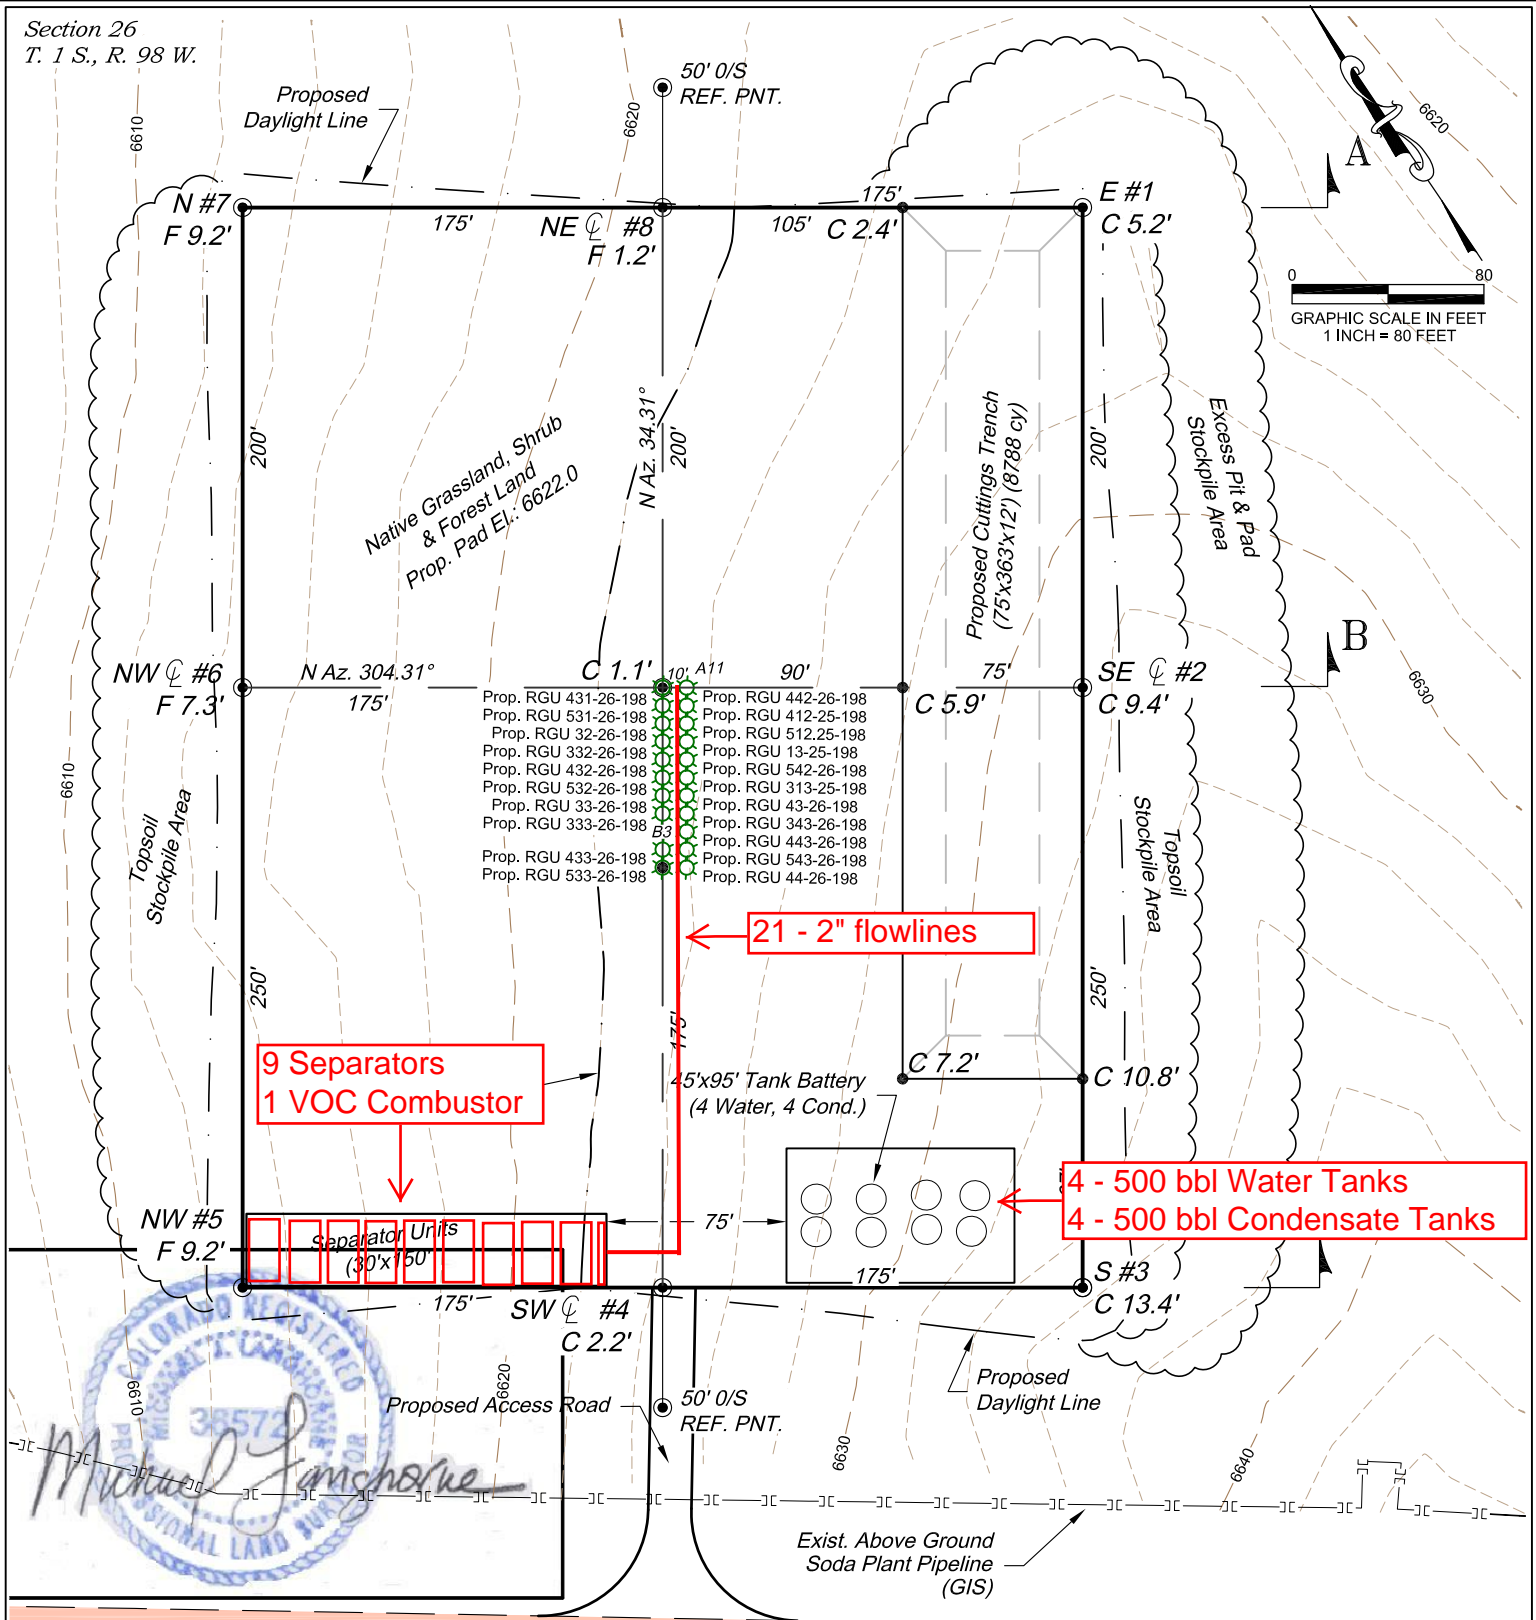

#### ESTIMATED EARTHWORK QUANTITIES (cy)

ITEM	CUT	FILL	TOPSOIL	EXCESS
PAD	18401	11499	6510	392
PIT	9660			9660
TOTALS	28061	11499	6510	10052

#### \*NOTE:

- 1.) 10% SWELL FACTOR APPLIED TO CUT VOLUME.
- 2.) TOPSOIL VOLUME BASED ON 12" SOIL DEPTH.
- 3.) TOTAL DISTURBED AREA = 6.78 ac.

REVISED: 3/18/13

136 East Third Street  
Rifle, Colorado 81650  
Ph. (970) 625-2720  
Fax (970) 625-2773



**BOOKCLIFF**  
Survey Services, Inc.

SCALE: 1" = 80'  
DATE: 2/21/13  
PROJECT: Highlands  
DFT: cws

**Construction Plan Prepared for:**  
 WPX Energy Rocky Mountain, LLC  
 RGU 42-26-198 Drill Pad - Plat 2  
**Production Equipment Detail Map**