

KERR-MCGEE OIL AND GAS ONSHORE LP

UPRR 42 PAN AM K 1

SW SW 27 1N 67W -- --

WELD,COLORADO

06/04/2013

AREA: S3

ROUTE: S36

Spud: 08/01/1973

WINS No.: 73769

AFE/WO#: 88368004

API#: 0512307792

GL: 5018

KB: 5028

MTD: 8300


TVD: 8300

LOG MD: 8299

PBMD: 8224

PBTVD: 8224

Directions: RD 4 & RD 19, E 2/10 MI, N 3/10 MI, TO LOCATION

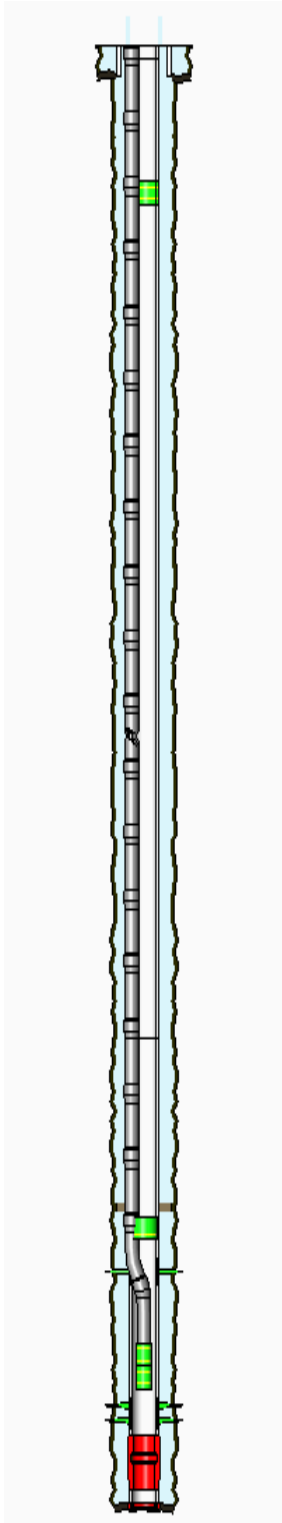

<u>HOLE SECTIONS</u>	<u>Size</u>	<u>Top</u>	<u>Btm</u>	<u>TD Date</u>				
SURFACE	12.25	10	217					
PRODUCTION	7.88	217	8300					
<u>TUBULARS</u>	<u>Tool Type</u>	<u>Joints</u>	<u>Size</u>	<u>Weight</u>	<u>Grade</u>	<u>Thread</u>	<u>Top D</u>	<u>Bottom D</u>
SURFACE CASING	Casing	5	8.63	24.00			10	217
PRODUCTION CASING	Casing	3	4.50	11.60	K-55	LTC	10	95
	Casing	24	4.50	10.50	K-55	LTC	95	886
	Cement Stage Too	1	4.50				886	887
	Casing	173	4.50	10.50	K-55	LTC	887	6437
	Casing	55	4.50	11.60	K-55	LTC	6437	8232
	Casing Float Collar	1					8232	8233
	Casing	1	4.50	11.60	K-55	LTC	8233	8299
	Casing Guide Shoe	1					8299	8300
BRIDGE PLUG	Cast Iron Bridge Plu	1	4.00				7620	7622
PRODUCTION TUBING	Tubing	257	2.37	4.70	J-55	8RD EUE	10	8137
	XN Profile Nipple	1	2.38				8137	8138
	Notched Collar	1	2.38				8138	8139
<u>CEMENT JOBS</u>	<u>Stage</u>	<u>Sacks</u>	<u>Cement Jobs</u>	<u>Top D</u>	<u>Btm D</u>	<u>cbl</u>		
SURFACE CASING	STAGE 1	175	LEAD UNKNOWN	10	217	No		
PRODUCTION CASING	STAGE 1	200	50/50 POZ MIX	10	876	No		
	STAGE 1	200	LEAD 50/50 POZ	7581	8300	No		
	STAGE 2			10	876	No		
PRODUCTION CASING	SQUEEZE JOB	108	LEAD FRESH WATER	0	7530	No		
<u>PERFORATIONS</u>	<u>Formation</u>	<u>Zone</u>	<u>Top</u>	<u>Btm</u>	<u>Date</u>	<u>Reason</u>	<u>Comments</u>	
			6800	6801	05/15/2013	CEMENT SQUEEZE	ALL SHOTS FIRED	
			7530	7531	05/15/2013	CEMENT SQUEEZE	ALL SHOTS FIRED	
	CODELL		7742	7752	12/15/1993	PRODUCTION		
	J SAND		8188	8212	11/16/1973	PRODUCTION		

Comments: