

KERR-MCGEE OIL AND GAS ONSHORE LP

BETZ 1

SW SW 4 4N 65W -- --

WELD,COLORADO

06/07/2013

AREA: N1

ROUTE: N13 Spud: 03/30/1982

WINS No.: 75928

AFE/WO#: 88335512

API#: 0512310622

GL: 4681

KB: 4692

MTD: 7170


TVD: 7170

LOG MD: 7167

PBMD: 7143

PBTVD: 7143

Directions: WCR 50 & WCR 41, S 8/10, E INTO

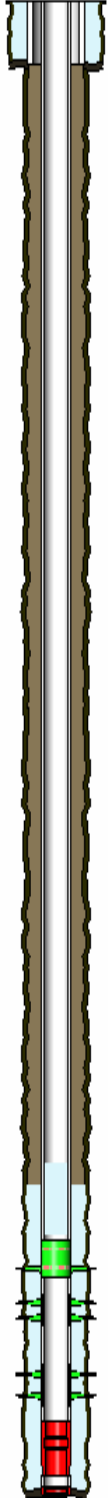

<u>HOLE SECTIONS</u>	<u>Size</u>	<u>Top</u>	<u>Btm</u>	<u>TD Date</u>				
SURFACE	12.25	11	354	03/30/1982				
PRODUCTION	7.88	354	7170	04/05/1982				
<u>TUBULARS</u>	<u>Tool Type</u>	<u>Joints</u>	<u>Size</u>	<u>Weight</u>	<u>Grade</u>	<u>Thread</u>	<u>Top D</u>	<u>Bottom D</u>
SURFACE CASING	Casing		8.63	24			11	354
PRODUCTION CASING	Casing		4.50	11.60			11	7143
	Casing Float Collar		4.50				7143	7144
	Casing		4.50	11.60			7144	7169
	Casing Guide Shoe		4.50				7169	7170
BRIDGE PLUG	CIBP With CMT Cap	1	4.50				6710	6810
<u>CEMENT JOBS</u>	<u>Stage</u>	<u>Sacks</u>	<u>Cement Jobs</u>			<u>Top D</u>	<u>Btm D</u>	<u>cbl</u>
SURFACE CASING	STAGE 1	225	UNKNOWN			11	354	No
PRODUCTION CASING	STAGE 1	176	UNKNOWN			6414	7170	Yes
PRODUCTION CASING	ABANDONMENT PLUG	25	LEAD	FRESH WATER		6290	6680	No
<u>PERFORATIONS</u>	<u>Formation</u>	<u>Zone</u>	<u>Top</u>	<u>Btm</u>	<u>Date</u>	<u>Reason</u>	<u>Comments</u>	
	NIOBRARA		6787	6792	02/07/1990	PRODUCTION		
	NIOBRARA		6898	6906	02/07/1990	PRODUCTION		
	CODELL		7080	7090	10/29/2001	PRODUCTION		
	CODELL		7084	7092	04/06/1982	PRODUCTION		

Comments: