


Well Completion Diagram

API Well No: 05-123-09062-00-		Well Name: FLORENCE B. SCHNEIDER #4	
Owner: TOP OPERATING COMPANY	County: WELD	Field: SPINDLE	Pool: 660 FEL
Coordinates: X 660 FEL	Y 1980 FNL	Sec: 25	Twp: 2N Rng: 67W

Note: Changes to the drawing do not effect the database

Bore Diameters (in.)

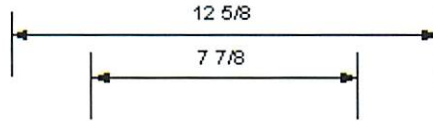

Cement Top: 0' mthd:U

Cement Top: 0' mthd:U

8 5/8" SURF 522'

Set 10 Sks cement @ surf

Perf. @ 700' Sqz w/ 60 Sks cement.

Set CIBP @ 4,500' W/2 Sks cmt on top

Perfs. 4,579-4,657'

2 3/8" Tubing 4,871'

Total Vertical Depth 4,765'

red = proposed operation