North Parachute UWF H04 596 Cuttings Area
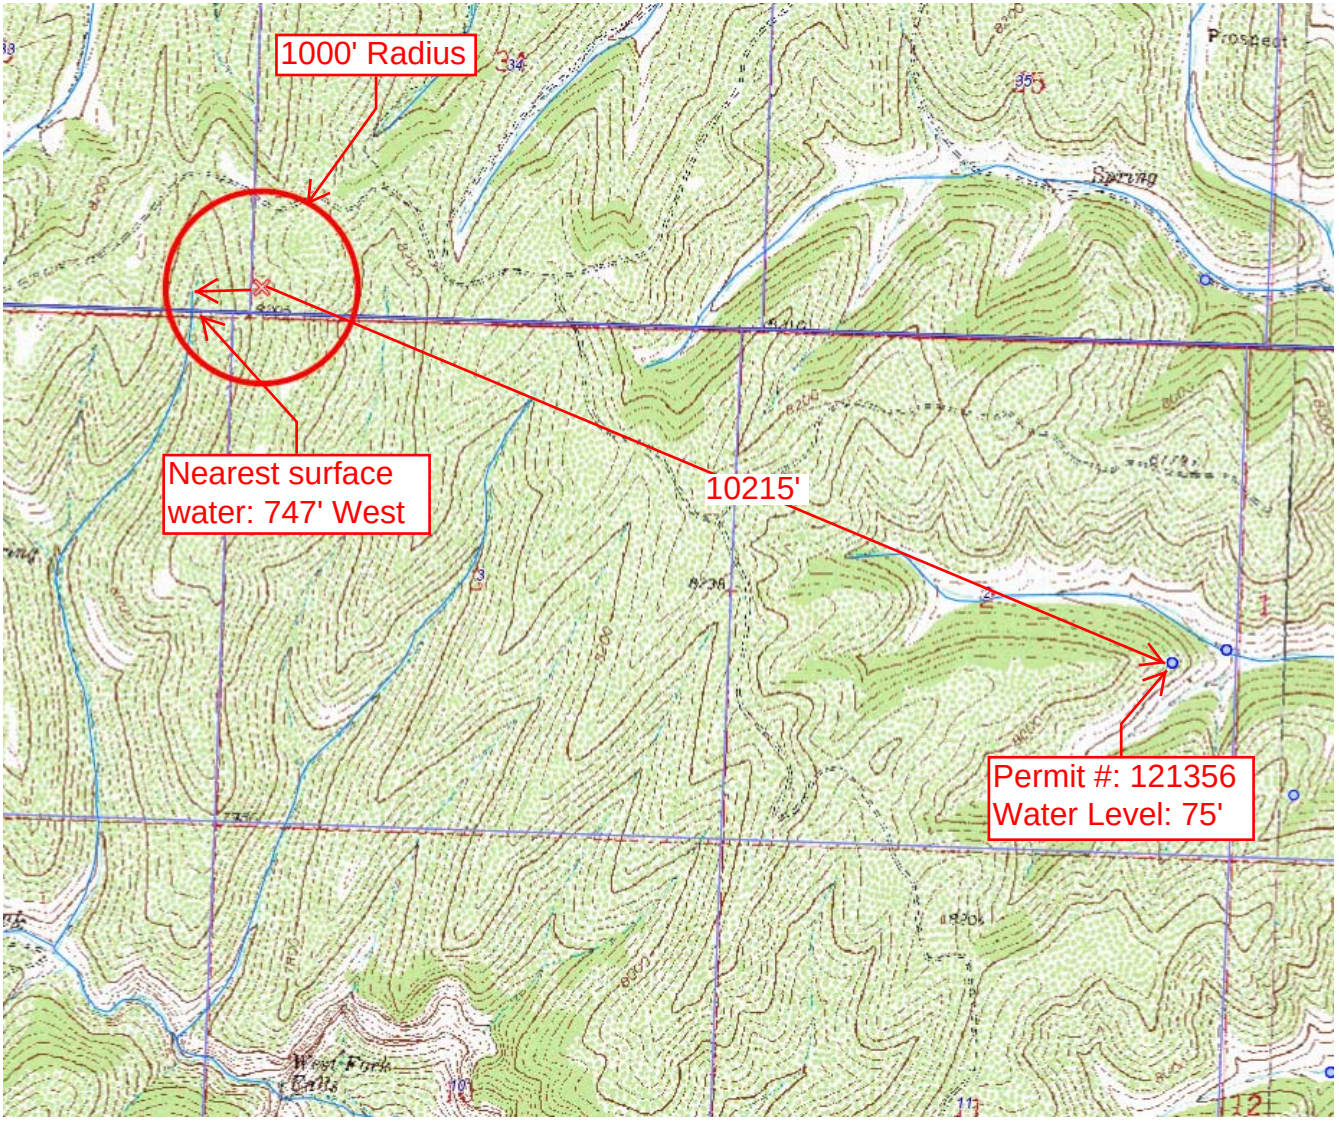
SWSW-Sec.34-T4S-R96W, Garfield County, CO